
GURVEY & REMONUMENTATION

REMONUMENTATION CORNER

OCT 1 1 1994 LAND CORNER RECORDATION CERTIFICATE COMMISSION Filing Requirement of Act 74, Mich. P.A. 1970 For corners in Ionia Located In: Corner Code ## . Public Land Survey T 7N_ R 8W_ T _____ R ____ Property Controlling in Section Miscellaneous Register of Deeds Stamp & File Number Property in Sec. ___ , Recorded Plat _ Lat No. Private Claims _ . in a field survey on hereby certify that under requirements of P.A. 74, Michigan P.A. of 1970, the corner points mentioned lines 1 and 2 above were in conformance with regulations and rules therefore as required in the ⊔rrent manual of survey instructions of the United States Department of the Interior, Bureau of Land anagement or by a decree of a Court of Law and/or that the corner points mentioned in lines 3, 4 and 5 ⊃ove were in conformance with the rules of the Michigan Board of Land Surveyors or by a Decree of a ⊃urt of Law; established, re-established, monumented, re-monumented, recovered, found as pressed below: IDTE: Not more than 4 corners, all in the same town and range, may be recorded on this certificate. Description of original monument and accessories and/or subsequent restoration: This corner was first established by U.S. Deputy Surveyor, Noah Brookfield in 1837. A wood post was set witnessed by a 10" White Oak N 44° W 56 links and a 10" White Oak S 12 1/2' E 9 links. Perpetuation: D.C. Crawford former Ionia County Surveyor performed a survey in Section 35, in 1903 found in Volume 3 page 30 of the Ionia County Surveyors Records. Crawford said he established the corner 1/2 way and set a iron stake and a stone but gave no witnesses. OVER PLEASE Description of corner evidence found and/or method applied in restoring or reestablishing corner: Excavated road bed with backhoe and found stone pile and a piece of deteriorated steel opposite fence line to East. Accepted this as the corner and placed a 3/4" x 24" steel bar in place of the deteriorated steel. Found T iron 2.62' South and 2.79' West of stone pile. Description of monument for corner and accessories established to perpetuate locating the position of the corner. Set 3/4" x 24" steel bar with a 2 3/4" diameter cap stamped "P.S. 25863" Witnessed by: Ratified by Peer Group Nail & tag North side 28" Cherry S 82° E 46.48' P.A. 345 Ionia County Nail & tag Northwest side 12" Pine N 46° E 63.99' Nail & tag Northeast side 18" Elm N 59° W 31.45' Nail & tag Southeast side 30" Oak S 44° W 44.94' Date 4-20-94 M.a.M. Marinus A. Mulder, Chairman aned by maris a mulch Date 4-21-94 rveyor's Michigan License No. 25863

inu 003 PAGE 104

FORM APPROVED BY MICHIGAN STATE BOARD OF LAND SURVEYORS, JAN. 28, 1971 REVISED MAY 14, 1975 REVISED JAN., 1983

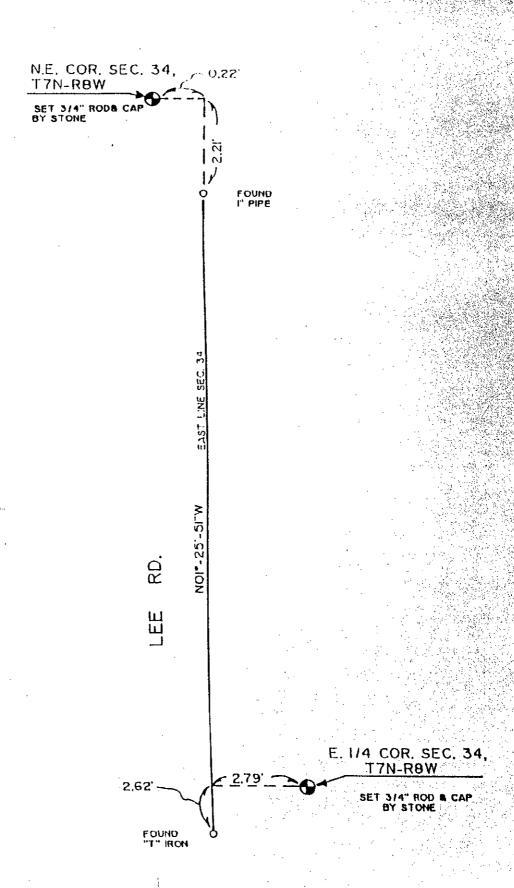

16 ha Pile M.