

**SURVEY &
REMONUMENTATION**

DEC 1 8 1996

COMMISSION

LAND CORNER RECORDATION CERTIFICATE
Filing Requirement of Act 74, Mich. P.A. 1970

LIBER **3** PAGE **250**

For corners in

IONIA
(County)

Located In:

Corner Code #

1. Public Land Survey T 7 N R 7 W F-8
 T _____ R _____
 T _____ R _____
 T _____ R _____
2. Property Controlling S _____ T _____ R _____
 in Section S _____ T _____ R _____
3. Miscellaneous S _____ T _____ R _____
 Property in Sec. S _____ T _____ R _____

4. Lot No. _____, Recorded Plat _____
 5. Private Claims _____

I, MARINUS MULDER, in a field survey on AUGUST 11 1996,

do hereby certify that under requirements of P.A. 74, Michigan P.A. of 1970, the corner points mentioned in lines 1 and 2 above were in conformance with regulations and rules therefore as required in the current manual of survey instructions of the United States Department of the Interior, Bureau of Land Management or by a decree of a Court of Law and/or that the corner points mentioned in lines 3, 4 and 5 above were in conformance with the rules of the Michigan Board of Land Surveyors or by a Decree of a Court of Law; established, re-established, monumented, re-monumented, recovered, found as expressed below:

NOTE: Not more than 4 corners, all in the same town and range, may be recorded on this certificate.

A. Description of original monument and accessories and/or subsequent restoration:

THIS CORNER WAS NOT SET BY THE U.S. GOVERNMENT SURVEYORS:

A.C. SMITH FORMER IONIA COUNTY SURVEYOR PERFORMED A SURVEY IN SECTION 21, APRIL 1875 RECORDED IN VOLUME 1, PAGE 100 OF THE IONIA COUNTY SURVEYORS RECORDS. SMITH DID NOT SAY WHAT WAS SET FOR F-8. THE IONIA COUNTY ROAD COMMISSION HAS NO INFORMATION ABOUT THIS CORNER PROFESSIONAL SURVEYOR DOUGLAS BONNEMA NO. 12579 RECORDED F-8 OCTOBER 1986 FOUND IN LIBER 2 PAGE 286 OF ACT 74 RECORDS. BONNEMA ESTABLISHED F-8 BY INTERSECTING THE 1/4 LINES, AND SET A 1/2" BAR AND CAP WITH 5 WITNESSES. THE CORNER IS 14' EAST OF AN EXISTING OCCUPATION FENCE TO THE SOUTH.


B. Description of corner evidence found and/or method applied in restoring or reestablishing corner:

FOUND BONNEMA'S ROD AND CAP BELOW THE ROAD SURFACE AND ACCEPTED THIS AS THE CORNER.

C. Description of monument for corner and accessories established to perpetuate locating the position of the corner:

REPLACED THE 1/2" ROD AND CAP WITH A 30" ALUMINUM MONUMENT WITH A 4" CAP STAMPED "IONIA COUNTY 25863" WITNESSED BY:

- NAIL & TAG EAST SIDE 36" OAK N 12° E 35.93 FEET
- NAIL & TAG WEST SIDE 36" OAK N 13° W 35.04 FEET
- NAIL & TAG EAST SIDE 22" OAK S 07° E 25.93 FEET
- NAIL & TAG NORTH SIDE 26" OAK S 48° E 34.99 FEET

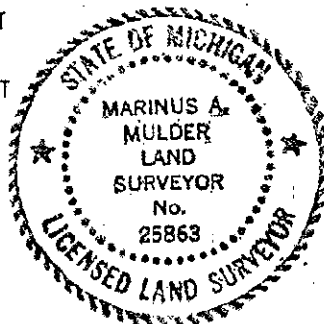

Ratified by Peer Group
P.A. 345 Ionia County

Date 9-26-96
Marinus A. Mulder, Chairman

	A	B	C	D	E	F	G	H	I	J	K	L	M
1													
2	6	5	4	3	2	1							
3													
4	7	8	9	10	11	12							
5													
6	18	17	16	15	14	13							
7													
8	19	20	21	22	23	24							
9													
10	30	29	28	27	26	25							
11													
12	31	32	33	34	35	36							
13													

Signed by Marinus A. Mulder Date OCTOBER 22, 1996
 Surveyor's Michigan License No. 25863