

**SURVEY &
REMONUMENTATION**

JAN 20 1999

LAND CORNER RECORDATION CERTIFICATE
Filing Requirement of Act 74, Mich. P.A. 1970

LISEX 4 PAGE 39

SECTION

For corners in	Located In:	Corner Code #
<u>IONIA</u>		
(County)		
1. Public Land Survey	T8 <u>N</u> R5 <u>W</u>	C-9 _____
	T _____ R _____	_____
	T _____ R _____	_____
	T _____ R _____	_____
2. Property Controlling in Section	S _____ T _____ R _____	_____
	S _____ T _____ R _____	_____
3. Miscellaneous Property in Sec.	S _____ T _____ R _____	_____
	S _____ T _____ R _____	_____
4. Lot No. _____, Recorded Plat _____		
5. Private Claims _____		

STATE OF MICHIGAN
IONIA COUNTY
RECEIVED FOR RECORD

25 NOV 98 2:51 P.M.

DIANE H. ADAMS
REGISTER OF DEEDS
Register of Deeds Stamp & File Number

I, MARINUS MULDER, in a field survey on AUGUST 19, 1998, do hereby certify that under requirements of P.A. 74, Michigan P.A. of 1970, the corner points mentioned in lines 1 and 2 above were in conformance with regulations and rules therefore as required in the current manual of survey instructions of the United States Department of the Interior, Bureau of Land Management or by a decree of a Court of Law and/or that the corner points mentioned in lines 3, 4 and 5 above were in conformance with the rules of the Michigan Board of Land Surveyors or by a Decree of a Court of Law; established, re-established, monumented, re-monumented, recovered, found as expressed below:

NOTE: Not more than 4 corners, all in the same town and range, may be recorded on this certificate.

A. Description of original monument and accessories and/or subsequent restoration:
THIS CORNER WAS FIRST ESTABLISHED BY U.S DEPUTY SURVEYOR ORANGE RISDON IN 1831, A WOOD POST WAS SET WITNESSED BY A 12" WHITE OAK S 74° W 13 LINKS AND A 12" WHITE OAK N 74° E 9 LINKS.

PERPETUATION: D.C. CRAWFORD FORMER IONIA COUNTY SURVEYOR PERFORMED A SURVEY OF SECTION 30, APRIL 29, 1890, RECORDED IN VOLUME 2, PAGE 136 OF THE IONIA COUNTY SURVEYORS RECORDS. CRAWFORD DID NOT STATE WHAT WAS SET OR FOUND FOR C-9.


THE IONIA COUNTY ROAD COMMISSION IMPROVED HAYES ROAD IN 1950, PROJECT CS-34-58, ON SHEET NO. 4 OF THE ROAD PLANS THE WITNESSES FOR C-9 ARE: 1/2" PIPE- 6" ELM N 23° E 92.20 FEET; FENCE CORNER POST S.E. 62.20 FEET; 24" ELM S 35° W 58.95 FEET.

B. Description of corner evidence found and/or method applied in restoring or reestablishing corner:
NO COUNTY ROAD COMMISSION WITNESSES REMAIN AT THE INTERSECTION OF HAYES ROAD AND CHARLES ROAD. EXCAVATED ROAD BED AND AT A DEPTH OF 3" FOUND A 3/4"x24" STEEL ROD. BENEATH THIS FOUND A 1/2"x14" PIPE BESIDE 2 STONES.

C. Description of monument for corner and accessories established to perpetuate locating the position of the corner:
REPLACED EXISTING MONUMENTATION WITH A 7/8" x 24" SOLID STEEL BAR WITH A 4" DIAMETER CAP STAMPED "IONIA COUNTY-P.S. 25863" WITNESSED BY:

NAIL & TAG	5" ASH	N 76° E 97.41 FEET
TOP CENTER LINE M.B.T. BOX		S 37° E 58.33 FEET
NAIL & TAG	S.W. SIDE 10" TRIPLE POPLAR	N 42° W 43.73 FEET
NAIL & TAG	N. SIDE 12" ASH	S 69° W 53.63 FEET

	A	B	C	D	E	F	G	H	I	J	K	L	M
1													
2	6	5	4	3	2	1							
3													
4	7	8	9	10	11	12							
5													
6	18	17	16	15	14	13							
7													
8	19	20	21	22	23	24							
9													
10	30	29	28	27	26	25							
11													
12	31	32	33	34	35	36							
13													

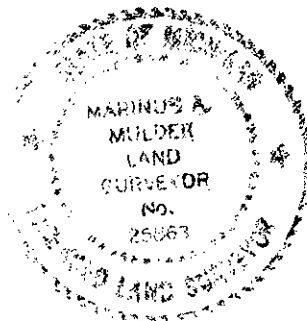

Ratified by Peer Group
P.A. 345 Ionia County

Date 9-16-98

Marinus A. Mulder, Chairman

Signed by Marinus A. Mulder

Date 11-11-98

Surveyor's Michigan License No. 25863