

DEC 16 1996

COMMISSION

LAND CORNER RECORDATION CERTIFICATE

Filing Requirement of Act 74, Mich. P.A. 1970

LIBER 3 PAGE 279

For corners in IONIA Located In: _____ Corner Code # _____
(County)

1. Public Land Survey T 8N R 6W L-2
 T _____ R _____
 T _____ R _____
 T _____ R _____

2. Property Controlling in Section S _____ T _____ R _____
 S _____ T _____ R _____

3. Miscellaneous Property in Sec. S _____ T _____ R _____
 S _____ T _____ R _____

4. Lot No. _____, Recorded Plat _____

5. Private Claims _____

STATE OF MICHIGAN
 IONIA COUNTY
 RECEIVED FOR RECORD

21 NOV 96 2:08 P.M.

DIANE M. ADAMS
 REGISTER OF DEEDS
 Register of Deeds Stamp & File Number

| | A | B | C | D | E | F | G | H | I | J | K | L | M |
|----|----|----|----|----|----|----|---|---|---|---|---|---|---|
| 1 | | | | | | | | | | | | | |
| 2 | 6 | 5 | 4 | 3 | 2 | 1 | | | | | | | |
| 3 | | | | | | | | | | | | | |
| 4 | 7 | 8 | 9 | 10 | 11 | 12 | | | | | | | |
| 5 | | | | | | | | | | | | | |
| 6 | 18 | 17 | 16 | 15 | 14 | 13 | | | | | | | |
| 7 | | | | | | | | | | | | | |
| 8 | 19 | 20 | 21 | 22 | 23 | 24 | | | | | | | |
| 9 | | | | | | | | | | | | | |
| 10 | 30 | 29 | 28 | 27 | 26 | 25 | | | | | | | |
| 11 | | | | | | | | | | | | | |
| 12 | 31 | 32 | 33 | 34 | 35 | 36 | | | | | | | |
| 13 | | | | | | | | | | | | | |

I, MARINUS MULDER, in a field survey on July 5 1994, do hereby certify that under requirements of P.A. 74, Michigan P.A. of 1970, the corner points mentioned in lines 1 and 2 above were in conformance with regulations and rules therefore as required in the current manual of survey instructions of the United States Department of the Interior, Bureau of Land Management or by a decree of a Court of Law and/or that the corner points mentioned in lines 3, 4 and 5 above were in conformance with the rules of the Michigan Board of Land Surveyors or by a Decree of a Court of Law; established, re-established, monumented, re-monumented, recovered, found as expressed below:


NOTE: Not more than 4 corners, all in the same town and range, may be recorded on this certificate.

A. Description of original monument and accessories and/or subsequent restoration:
 THE CENTER OF SECTION WAS NOT SET BY THE ORIGINAL GOVERNMENT SURVEYORS.
 ESTABLISHMENT: D.C. CRAWFORD FORMER IONIA COUNTY SURVEYOR PERFORMED A SURVEY IN THE NE 1/4 OF SECTION 1, DECEMBER 11, 1883 WHICH IS RECORDED IN VOLUME 1 PAGE 330 OF THE IONIA COUNTY SURVEYORS RECORDS. CRAWFORD DID NOT SAY WHAT WAS SET FOR THE SECTION CENTER. THE IONIA COUNTY ROAD COMMISSION RECONSTRUCTED AND PAVED VAN VLECK ROAD IN 1962. THE PROJECT NO. IS C S 34-81. THE ROAD COMMISSION SHOWS NO INFORMATION FOR L-2.

B. Description of corner evidence found and/or method applied in restoring or reestablishing corner:
 EXCAVATED ROAD BED AND FOUND 3/4" SQUARE SHAFT 12" DEEP. REMOVED SHAFT BUT FOUND NO OTHER EVIDENCE.
 INTERSECTED THE NORTH-SOUTH AND EAST-WEST 1/4 LINES AND ESTABLISHED A TRUE CENTER POSITION. THE EXISTING MONUMENTATION IS 1.18 FEET WEST AND 10.13 FEET NORTH OF THE INTERSECTION OF THE 1/4 LINES.

ACCEPTED THE EXISTING MONUMENTATION FOR THE CENTER OF SECTION 1.

C. Description of monument for corner and accessories established to perpetuate locating the position of the corner:
 REMOVED THE SQUARE SHAFT AND SET A 32" FIBERGLASS MONUMENT WITH A 4" DIAMETER BRONZE CAP STAMPED "IONIA COUNTY SURVEY MONUMENT - DO NOT DISTURB"
 WITNESSED BY:
 NAIL & TAG POWER POLE N 45° W 48.94'
 NAIL & TAG POWER POLE S 59° W 46.14'
 NAIL & TAG POWER POLE N 53° E 38.75'
 CENTERLINE OF 3/8" RE-BAR LOCATED ON THE NORTH CORNER OF A CONCRETE COUNTY ROAD PROJECT MARKER S 50° E 46.95'
 1 FOOT NORTH OF ROAD CENTERLINE

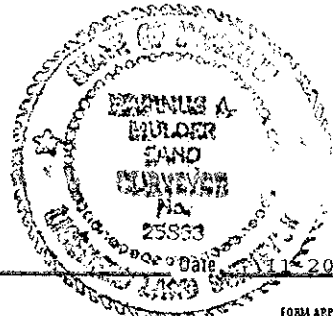

Witnessed by Peer Group
 P.A. 345 Ionia County

Date 11-13-96
 Marinus A. Mulder, C.S.M.

Signed by Marinus A. Mulder

Surveyor's Michigan License No. 25833