

LAND CORNER RECORDATION CERTIFICATE
Filing Requirement of Act 74, Mich. P.A. 1970

For corners in
 1001a

_____ (County)	Located In:	Corner Code =#
1. Public Land Survey	T 8N R 7W T 8N R 7W T 8N R 7W T _____ R _____	RC South of B1 B2 B3
2. Property Controlling in Section	S _____ T _____ R _____ S _____ T _____ R _____	_____
3. Miscellaneous Property in Sec.	S _____ T _____ R _____ S _____ T _____ R _____	_____

Register of Deeds Stamp & File Number

4. Lot No. _____, Recorded Plat _____
 5. Private Claims _____

B3 June 02, 1992
 B2 April 30, 1992
 RC June 02, 1992

I, Gary C. Bilow, in a field survey on _____, 19____, do hereby certify that under requirements of P.A. 74, Michigan P.A. of 1970, the corner points mentioned in lines 1 and 2 above were in conformance with regulations and rules therefore as required in the current manual of survey instructions of the United States Department of the Interior, Bureau of Land Management or by a decree of a Court of Law and/or that the corner points mentioned in lines 3, 4 and 5 above were in conformance with the rules of the Michigan Board of Land Surveyors or by a Decree of a Court of Law; established, re-established, monumented, re-monumented, recovered, found as expressed below:

A	B	C	D	E	F	G	H	I	J	K	L	M
2	●		5	4	3							
3	●											
4	7	8	9	10	11	12						
5												
6	18	17	16	15	14	13						
7												
8	19	20	21	22	23	24						
9												
10	30	29	28	27	26	25						
11												
12	31	32	33	34	35	36						
13												

NOTE: Not more than 4 corners, all in the same town and range, may be recorded on this certificate.

A. Description of original monument and accessories and/or subsequent restoration:

B1: Not set in original survey. County Surveyor Crawford in 1891 reports that the corner falls in a creek 32 links north of a post he set and witnessed to a Maple 2, N5E, 21 links and a B Oak 14, S43E, 64 links.
 B2: Not set in original survey. County Surveyor Crawford reports setting a stake and stone for this corner in 1883 and witnesses an Elm, N1E, 25 links and an Elm, S16E, 46 links. In 1891 he reports that an elm stump stood north of the corner. Surveyor Wm Tingley reports setting a PK&washer at the intersection of the 1/4 lines.
 B3: Post set by US Deputy Surveyor N. Brookfield in 1837, accessories W Oak 12, S2E, 13 links and W Oak 14, North, 12 links. County Surveyor Crawford in 1891 witnesses the corner to a W Oak 16, S73E, 1.31 chains and a W Oak 20, N87-1/2W, 1.31 chains. T Chettleburgh, in an Act 74 Certificate in Liber 2, page 133 reports finding an iron bar in Kiddville Road in line with fences north and south and witnesses 18" Oak NE 40.63, 50" Oak ESE 90.84, Power Pole SE 39.70, 18" Oak SW 22.92 and 12" Oak WNW 44.13.


B. Description of corner evidence found and/or method applied in restoring or reestablishing corner:

B1: Established corner location 40 chains proportional measure West of Corner C1 on township line. This position falls in Dickerson Creek. Set Reference Corner(RC) 120 feet south on North-South 1/4 line.
 B2: Crawford's corner and accessories were not found. Tingley's corner was found but rejected because corners B1 and C2 which he relied upon have been moved. Established this corner at the intersection of lines connecting corner A2 with corner C2 and corner B1 with corner B3.
 B3: Found 1/2" iron pipe. Chettleburgh's witness to 50" Oak is 4.3 feet longer than 1891 tie to a 16" Oak but nothing was found at the record distance. Accepted 1/2" pipe as best evidence of original GLO corner location.

C. Description of monument for corner and accessories established to perpetuate locating the position of the corner:

RC South of B1: Set 1/2" rebar encased in 4" diameter concrete cylinder with a cast aluminum MI Department of Natural Resources tablet. S37W, 37.41, spike&tag in 16" Oak N72W, 40.30, spike&tag in 12" Oak N33E, 41.60, spike&tag in 19" Maple S50E, 34.33, spike&tag in 19" Maple	B2: Set 1/2" rebar with plastic cap "G.C. BILOW LLS 26453" in monument box S67E, 112.76, spike&tag in 18" W Pine N25W, 53.09, spike&tag in 20" Ash N13E, 62.73, spike&tag in 6" twin Elm East, 84, centerline of drive North, 7, centerline Long Lake Road	B3: Left 1/2" pipe in place N52E, 40.22, spike&tag in 24" Oak N61W, 34.34, spike&tag in 15" triple Oak N25E, 30.25, spike&tag in 30" Oak N47E, 39.73, nail in utility pole North, 1.0, center line Kiddville Road
---	---	--

Signed by Gary C. Bilow Date _____
 Surveyor's Michigan License No. 26453

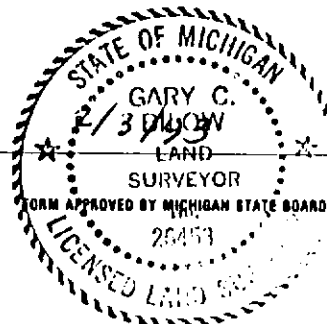

FORM APPROVED BY MICHIGAN STATE BOARD OF LAND SURVEYORS, JAN. 28, 1971
 REVISED MAY 14, 1975
 REVISED JAN., 1983