

LAND CORNER RECORDATION CERTIFICATE
Filing Requirement of Act 74, Mich. P.A. 1970

For corners in
 Ionia

	(County)	Located In:	Corner Code -##
1. Public Land Survey		T <u>6N</u> R <u>7W</u>	<u>C2</u>
		T _____ R _____	_____
		T _____ R _____	_____
		T _____ R _____	_____
2. Property Controlling in Section	S <u>6</u>	T <u>8N</u> R <u>7W</u>	<u>9</u>
	S _____	T _____ R _____	_____
3. Miscellaneous Property in Sec.	S _____	T _____ R _____	_____
	S _____	T _____ R _____	_____

Register of Deeds Stamp & File Number

4. Lot No. _____, Recorded Plat _____
 5. Private Claims _____

9 April 30, 1992

I, Gary C. Bilow, in a field survey on C2 May 01, 1992, 19_____, do hereby certify that under requirements of P.A. 74, Michigan P.A. of 1970, the corner points mentioned in lines 1 and 2 above were in conformance with regulations and rules therefore as required in the current manual of survey instructions of the United States Department of the Interior, Bureau of Land Management or by a decree of a Court of Law and/or that the corner points mentioned in lines 3, 4 and 5 above were in conformance with the rules of the Michigan Board of Land Surveyors or by a Decree of a Court of Law; established, re-established, monumented, re-monumented, recovered, found as expressed below:

NOTE: Not more than 4 corners, all in the same town and range, may be recorded on this certificate.

	A	B	C	D	E	F	G	H	I	J	K	L	M
2		6	●	5		4		3		2		1	
3													
4		7		8		9		10		11		12	
5													
6		18		17		16		15		14		13	
7													
8		19		20		21		22		23		24	
9													
10		30		29		28		27		26		25	
11													
12		31		32		33		34		35		36	
13													

A. Description of original monument and accessories and/or subsequent restoration:

C2: Post set by US Deputy Surveyor N. Brookfield in 1837, accessories Pine 30, N86W, 31 links and Pine 8, N2E, 25 links. County surveyor Crawford in 1883 found the original post and set a stake and stone. In 1891 he witnessed the stake and stone to a W Oak 2, N23W, 67 links and a W Oak 6, S42-1/2W, 65 links. Ionia County Road Commission records call for a large stone raised with oak stake witnessed 15" Oak, S56W, 58.55 and 12" Oak, N34E, 44.95. Surveyor R Dunn in a survey recorded in Liber 439, page 896 set a nail for this corner "2640 feet north of section corner and according to old witnesses on record". Nail has been used in subsequent surveys by Glaza and Mulder.

9: Corner not set in original survey. County Surveyor Crawford does not report setting this corner in his 1883 survey in Section 6.


B. Description of corner evidence found and/or method applied in restoring or reestablishing corner:

C2: Found old cabin spike 18" below surface of Long Lake Road at 1891 bearing and distance from a large White Oak southwest. Distances from cabin spike to section corners north and south closely match 1883 survey. Rejected Dunn's nail and accepted cabin spike as best evidence of original GLO corner location.

9: Established corner midway and on line between corners B2 and C2.

C. Description of monument for corner and accessories established to perpetuate locating the position of the corner:

C2: Set 4" diameter aluminum Michigan Department of Natural Resources cap on 1/2"x24" rebar inside 3/4" pipe in monument box and witnessed:
 N34E, 67.64, spike and tag in 10" Oak
 S40W, 43.48, spike and tag in 39" Oak
 N69W, 66.72, spike in utility pole
 N44E, 94.22, spike and tag in 25" Oak
 S50E, 51.61, spike and tag in 9" W Pine
 N15E, 17.12, RR spike over PK nail

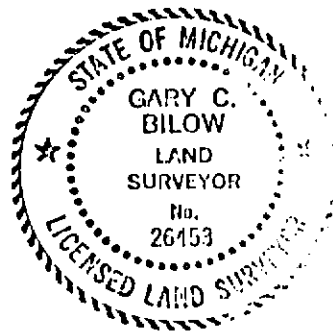

9: Set 1/2" rebar with plastic cap "G.C.BILOW LLS 26453" in monument box.
 N60W, 61.26, spike&tag in 30" Maple
 S40E, 36.80, spike&tag in 40" Maple
 S34W, 31.49, spike&tag in RR tie fence post
 South, 4.0, centerline of Long Lake Rd
 East, 7.0, centerline drive

Signed by Gary C. Bilow Date 2/3/93
 Surveyor's Michigan License No. 26453