

**LAND CORNER RECORDATION CERTIFICATE**  
**Filing Requirement of Act 74, Mich. P.A. 1970**

For corners in  
Ionia  
(County)

Located In: \_\_\_\_\_ Corner Code =# \_\_\_\_\_

1. Public Land Survey	T _____ R _____	_____
	T _____ R _____	_____
	T _____ R _____	_____
	T _____ R _____	_____
2. Property Controlling in Section	S <u>6</u> T <u>8N</u> R <u>7W</u>	<u>2</u>
	S <u>6</u> T <u>8N</u> R <u>7W</u>	<u>5</u>
3. Miscellaneous Property in Sec.	S <u>6</u> T <u>8N</u> R <u>7W</u>	<u>6</u>
	S _____ T _____ R _____	_____

Register of Deeds Stamp & File Number

4. Lot No. \_\_\_\_\_, Recorded Plat \_\_\_\_\_  
 5. Private Claims \_\_\_\_\_

6 April 29, 1992

5 May 01, 1992

2 April 28, 1992

I, Gary C. Bilow, in a field survey on 2 April 28, 1992, 19\_\_\_\_\_, do hereby certify that under requirements of P.A. 74, Michigan P.A. of 1970, the corner points mentioned in lines 1 and 2 above were in conformance with regulations and rules therefore as required in the current manual of survey instructions of the United States Department of the Interior, Bureau of Land Management or by a decree of a Court of Law and/or that the corner points mentioned in lines 3, 4 and 5 above were in conformance with the rules of the Michigan Board of Land Surveyors or by a Decree of a Court of Law, established, re-established, monumented, re-monumented, recovered, found as expressed below:

**NOTE: Not more than 4 corners, all in the same town and range, may be recorded on this certificate.**

A	B	C	D	E	F	G	H	I	J	K	L	M
2	6		5		4		3		2		1	
3												
4	7		8		9		10		11		12	
5												
6	18		17		16		15		14		13	
7												
8	19		20		21		22		23		24	
9												
10	30		29		28		27		26		25	
11												
12	31		32		33		34		35		36	
13												

A. Description of original monument and accessories and/or subsequent restoration:

2: Not set in original survey. County Surveyor Crawford set a stake for this corner in 1883 and witnessed a Pine 30. N56-1/2W, 84 links.

5: Not set in original survey. County Surveyor Crawford does not reference this corner in his 1883 survey in Section 6.


6: Corner not set in original survey. County Surveyor Crawford set a stake for this corner in 1883 and witnessed a White Oak 11 links SW and a Pine 18 links SE.

B. Description of corner evidence found and/or method applied in restoring or reestablishing corner:

2: Crawford's stake and witness were not found. Established corner midway between B1 and C1 on the township line.

5: Established corner 20 chains proportional measure north of corner B2 on line between corner B2 and corner B1.

6: Crawford's stake and witnesses were not found. Established corner at the intersection of lines connecting corner 2 with corner 9 and corner 5 with corner 7.

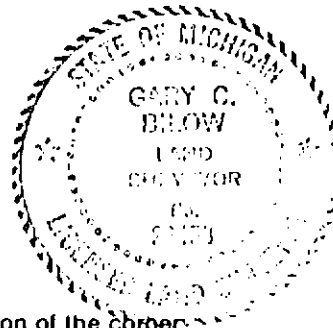

C. Description of monument for corner and accessories established to perpetuate locating the position of the corner:

2: Set 1/2" x 36" rebar encased in a 4" diameter concrete cylinder capped with a cast aluminum Michigan Department of Natural Resources tablet.

S85E, 42.25, spike&tag in 20" W Pine

West, 4.94, spike&tag in 10" W Oak

S60E, 8.87, spike&tag in 10" W Oak

S06E, 19.83, spike&tag in 9" W Oak

5: Set 1/2" x 36" rebar encased in a 4" diameter concrete cylinder capped with a cast aluminum Michigan Department of Natural Resources tablet.

N50E, 26.40, spike&tag in 30" Maple

N88W, 26.40, spike&tag in 14" W Oak

S48W, 26.52, spike&tag in 15" tw n W Oak

S55E, 12.60, spike&tag in 7" Elm

South, 100, north edge of water

6: Set 1/2" x 36" rebar encased in a 4" diameter concrete cylinder capped with a cast aluminum Michigan Department of Natural Resources tablet.

S76E, 44.39, spike&tag in 12" W Pine

S22E, 34.82, spike&tag in 4" W Pine

S32W, 13.89, spike&tag in 5" Oak

S73W, 11.91, spike&tag in 6" Oak

Near top of creek bluff

Signed by Gary C. Bilow

Date 2/3/93

Surveyor's Michigan License No. 26453