

REF
 JAN 18 2000

LAND CORNER RECORDATION CERTIFICATE
 Filing Requirement of Act 74, Mich. P.A. 1970

LIBER 4 PAGE 91

For corners in SECTION
IONIA
 (County)

Located In: _____ Corner Code # _____

1. Public Land Survey T 8 N R 8 W B-9
 T _____ R _____
 T _____ R _____
 T _____ R _____

2. Property Controlling S _____ T _____ R _____
 in Section S _____ T _____ R _____

3. Miscellaneous S _____ T _____ R _____
 Property in Sec. S _____ T _____ R _____

4. Lot No. _____, Recorded Plat _____

5. Private Claims _____

STATE OF MICHIGAN
 IONIA COUNTY
 RECEIVED FOR RECORD

23 NOV 99 2:59 P.M.

DIANE M. ADAMS
 REGISTER OF DEEDS

Register of Deeds Stamp & File Number

	A	B	C	D	E	F	G	H	I	J	K	L	M
1													
2	6	5	4	3	2	1							
3													
4	7	8	9	10	11	12							
5													
6	18	17	16	15	14	13							
7													
8	19	20	21	22	23	24							
9													
10	30	29	28	27	26	25							
11													
12	31	32	33	34	35	36							
13													

I, MARINUS MULDER, in a field survey on SEPTEMBER 3 1999,
 do hereby certify that under requirements of P.A. 74, Michigan P.A. of 1970, the corner points mentioned in
 lines 1 and 2 above were in conformance with regulations and rules therefore as required in the
 current manual of survey instructions of the United States Department of the Interior, Bureau of Land
 Management or by a decree of a Court of Law and/or that the corner points mentioned in lines 3, 4 and 5
 above were in conformance with the rules of the Michigan Board of Land Surveyors or by a Decree of a
 Court of Law; established, re-established, monumented, re-monumented, recovered, found as
 expressed below:

NOTE: Not more than 4 corners, all in the same town and range, may be recorded
 on this certificate.

A. Description of original monument and accessories and/or subsequent restoration:
 THIS CORNER WAS FIRST ESTABLISHED BY U.S. DEPUTY SURVEYOR NOAH BROOKFIELD IN 1837. A WOOD
 POST WAS SET WITNESSED BY A 8" ASPEN S 22° W 15 LINKS AND A 6" BLACK OAK N 39° E 6 LINKS.

PERPETUATION: THOMAS CORNELL FORMER IONIA COUNTY SURVEYOR PERFORMED A SURVEY OF SECTION 30, FEBRUARY 19 THRU 23, 1875 RECORDED IN
 VOLUME 1, PAGE 264 OF IONIA COUNTY SURVEYORS RECORDS. CORNELL DID NOT SAY WHAT HE SET OR GAVE NO WITNESSES FOR B-9. CORNELL ALSO
 PERFORMED A SURVEY OF SECTION 19, OCTOBER 25 - 28 AND MARCH 1, 1878 RECORDED IN VOLUME 1, PAGE 266 OF IONIA COUNTY SURVEYORS RECORDS.
 CORNELL DID NOT SAY WHAT HE SET FOR B-9.

THE IONIA COUNTY ROAD COMMISSION IMPROVED BUTTON ROAD IN CIRCA 1959.

THE IONIA COUNTY ROAD COMMISSION WITNESS INDEX MAP FOR OTISCO TOWNSHIP CALLS FOR A 1" IRON PIPE WITNESSED BY: FENCE POST N.W. 37.90 FEET;
 FENCE POST NORTH 35.13 FEET; FENCE POST SOUTH 21.45 FEET. "1958"

PROFESSIONAL SURVEYOR EDWARD GLAZA JR. NO. 9548 RECORDED B-9 MARCH 21, 1985 FOUND IN LIBER 2 PAGE 253 OF ACT 74 RECORDS. GLAZA FOUND A
 3/4" IRON PIPE FOUND BY COUNTY WITNESSES. GLAZA'S WITNESSES ARE: V-CUT IN TOP N. SIDE 12" CONCRETE CULVERT N 10° E 34.97 FEET; V-CUT IN TOP S.
 SIDE 12" CONCRETE CULVERT S 35° E 15.02 FEET. CENTERLINE ROAD NORTH 8.0 FEET.

PROFESSIONAL SURVEYOR THOMAS CHETTLEBURGH NO. 16036 RECORDED B-9 JUNE 24, 1996, FOUND IN LIBER 3 PAGE 242 OF ACT 74 RECORDS.
 CHETTLEBURGH FOUND AN IRON PIPE 8' SOUTH OF ROAD CENTERLINE. CHETTLEBURGH'S NEW WITNESSES ARE: IRON BAR NORTH 8.13 FEET; SPIKE IN POWER
 POLE S 67° W 150.44 FEET; SPIKE 12" HICKORY S 87° W 125.03 FEET; SPIKE POWER POLE N 68° W 139.84 FEET.


B. Description of corner evidence found and/or method applied in restoring or reestablishing corner:
 AT A POINT 8 FEET SOUTH OF THE CENTERLINE OF BUTTON ROAD AND OPPOSITE FENCE LINE NORTH & SOUTH FOUND A 1" X 21" PIPE 8" BELOW THE ROAD
 SURFACE. EXCAVATED TO A DEPTH OF 40" BUT FOUND NO OTHER EVIDENCE. A CULVERT CROSSES BUTTON ROAD ABOUT 10' EAST OF THIS CORNER.

C. Description of monument for corner and accessories established to perpetuate locating the position of the corner:
 REPLACED THE 1" PIPE WITH A 7/8" X 30" STEEL BAR WITH A 4" DIAMETER CAP STAMPED "IONIA COUNTY MONUMENT - P.S. 25863" SET IN A MONUMENT
 BOX
 WITNESSED BY:

NAIL & TAG NORTH SIDE POWER POLE NORTH 72° WEST 139.72 FEET
 NAIL & TAG EAST SIDE FENCE POST SOUTH 48° EAST 33.29 FEET
 NAIL & TAG NORTHEAST SIDE 18" HICKORY SOUTH 83° WEST 125.05 FEET
 NAIL & TAG WEST SIDE 12" QUAD BOX ELDER NORTH 33.65 FEET
 CENTERLINE OF BUTTON ROAD NORTH 8 FEET

Signed by marinus a mulder Date 11-3-99

Surveyor's Michigan License No. 25863

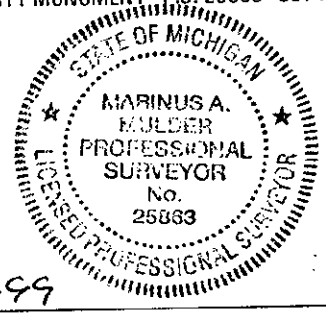

Ratified by Peer Group
 P.A. 345 Ionia County

Date September 23, 1999
 Marinus A. Mulder, Chairman