

**SURVEY &
REMONUMENTATION**

DEC 1 8 1996

COMMISSION

LAND CORNER RECORDATION CERTIFICATE
Filing Requirement of Act 74, Mich. P.A. 1970

LIBER **3** PAGE **259**

For corners in IONIA Located In: _____ Corner Code # _____
(County)

1. Public Land Survey T8 N R8 W D-13
T _____ R _____
T _____ R _____
T _____ R _____

2. Property Controlling S _____ T _____ R _____
in Section S _____ T _____ R _____

3. Miscellaneous S _____ T _____ R _____
Property in Sec. S _____ T _____ R _____

4. Lot No. _____, Recorded Plat _____

5. Private Claims _____

STATE OF MICHIGAN
IONIA COUNTY
RECEIVED FOR RECORD

24 OCT 96 3:55 P.M.

DIANE H. ADAMS
REGISTER OF DEEDS

Register of Deeds Stamp & File Number

	A	B	C	D	E	F	G	H	I	J	K	L	M
1													
2	6	5	4	3	2	1							
3													
4	7	8	9	10	11	12							
5													
6	18	17	16	15	14	13							
7													
8	19	20	21	22	23	24							
9													
10	30	29	28	27	26	25							
11													
12	31	32	33	34	35	36							
13													

I, MARINUS MULDER, in a field survey on JUNE 10 1996, do hereby certify that under requirements of P.A. 74, Michigan P.A. of 1970, the corner points mentioned in lines 1 and 2 above were in conformance with regulations and rules therefore as required in the current manual of survey instructions of the United States Department of the Interior, Bureau of Land Management or by a decree of a Court of Law and/or that the corner points mentioned in lines 3, 4 and 5 above were in conformance with the rules of the Michigan Board of Land Surveyors or by a Decree of a Court of Law; established, re-established, monumented, re-monumented, recovered, found as expressed below:

NOTE: Not more than 4 corners, all in the same town and range, may be recorded on this certificate.

A. Description of original monument and accessories and/or subsequent restoration:

THIS CORNER WAS FIRST ESTABLISHED BY U.S. DEPUTY SURVEYOR NOAH BROOKFIELD IN 1837. A WOOD POST WAS SET WITNESSED BY A : 12" WHITE OAK N 42° E 31 LINKS AND A 10" WHITE OAK N 66° W 61 LINKS.

PERPETUATION: NO COUNTY SURVEYS ARE RECORDED FOR SECTION 32, BUT D.C. CRAWFORD FORMER IONIA COUNTY SURVEYOR PERFORMED A SURVEY OF SECTION 5, T7N-R8W DECEMBER 1888, RECORDED IN VOLUME 1, PAGE 472 OF THE IONIA COUNTY SURVEYORS RECORDS. CRAWFORD SAID HE RESET A STAKE AND STONE FOR D 13. CRAWFORD ALSO SHOWS THE WITNESSES TO THIS CORNER AS A MARGINAL NOTE FOUND IN THE IONIA COUNTY SURVEYORS COPY OF THE G.L.O. NOTES ON PAGE 591. CRAWFORD WROTE 1888-RESET 1/4 POST WITH STAKE AND STONE, 1 ORIGINAL G.L.O. WITNESSES REMAINS AND NEW WITNESS 12" WHITE OAK N 40° W 53 1/4 LINKS.

B. Description of corner evidence found and/or method applied in restoring or reestablishing corner:


NO WITNESS TREES FROM 1888 REMAIN. THIS CORNER IS IN A PASTURED AREA, MEASURED WEST FROM A NORTH-SOUTH FRACTIONAL FENCE LINE TO GET INTO A SEARCH RADIUS. STARTED HAND DIGGING AND FOUND 3 LARGE STONES IN A 2 FOOT DIAMETER CIRCLE WITH SMALLER STONES IN BETWEEN. ALSO FOUND THE SAME TYPE OF STONE PILE 28 LINKS (18.48 FEET) EAST BEING THE NORTH 1/4 CORNER FOR SECTION 5, T7N-R8W, AS CALLED FOR BY CRAWFORD. ACCEPTED THIS AS THE CORNER WHICH CRAWFORD SET IN 1888 AND A PERPETUATION OF THE ORIGINAL CORNER.

C. Description of monument for corner and accessories established to perpetuate locating the position of the corner:

SET A 3/4" X 36" STEEL ROD WITH A 2 3/4" DIAMETER CAP STAMPED "IONIA COUNTY 25863" IN THE CENTER OF THE 3 LARGE STONES WITNESSED BY:
 NAIL & TAG SOUTH SIDE 18" HICKORY S 67° E 69.94 FEET
 NAIL & TAG SOUTHEAST SIDE 20" CHERRY N 84° E 24.73 FEET
 NAIL & TAG NORTHWEST SIDE 30" MAPLE S 32° E 37.39 FEET
 NAIL & TAG SOUTH SIDE 5" HAWTHORNE S 70° W 4.33 FEET
 NORTH 1/4 CORNER SECTION 5, T7N-R8W 3/4" ROD & CAP EAST 18.53 FEET

Ratified by Peer Grp.
P.A. 345 Ionia Cou

Date 9-26-96
Marinus A. Mulder, C

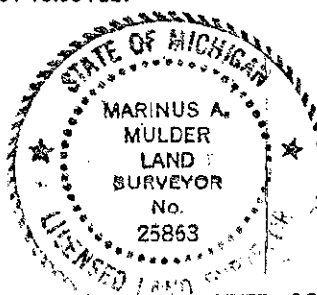

Signed by Marinus A. Mulder

Date OCTOBER 22, 1996

Surveyor's Michigan License No. 25863