

DEC 16 1996

COMMISSION

LAND CORNER RECORDATION CERTIFICATE

Filing Requirement of Act 74, Mich. P.A. 1970

LIBER 3 PAGE 260

For corners in IONIA Located in: _____ Corner Code # _____
 (County)

1. Public Land Survey T8 N R8 W I-10
 T _____ R _____
 T _____ R _____
 T _____ R _____

2. Property Controlling S _____ T _____ R _____
 in Section S _____ T _____ R _____

3. Miscellaneous S _____ T _____ R _____
 Property in Sec. S _____ T _____ R _____

4. Lot No. _____ Recorded Plat _____

5. Private Claims _____

STATE OF MICHIGAN
 IONIA COUNTY
 RECEIVED FOR RECORD

24 OCT 96 3:55 P.M.

DIANE M. ADAMS
 REGISTER OF DEEDS

Register of Deeds Stamp & File Number

	A	B	C	D	E	F	G	H	I	J	K	L	M
1													
2	6	5	4	3	2	1							
3													
4	7	8	9	10	11	12							
5													
6	18	17	16	15	14	13							
7													
8	19	20	21	22	23	24							
9													
10	30	29	28	27	26	25							
11													
12	31	32	33	34	35	36							
13													

I, MARINUS MULDER, in a field survey on JULY 9 1996, do hereby certify that under requirements of P.A. 74, Michigan P.A. of 1970, the corner points mentioned in lines 1 and 2 above were in conformance with regulations and rules therefore as required in the current manual of survey instructions of the United States Department of the Interior, Bureau of Land Management or by a decree of a Court of Law and/or that the corner points mentioned in lines 3, 4 and 5 above were in conformance with the rules of the Michigan Board of Land Surveyors or by a Decree of a Court of Law; established, re-established, monumented, re-monumented, recovered, found as expressed below:

NOTE: Not more than 4 corners, all in the same town and range, may be recorded on this certificate.

A. Description of original monument and accessories and/or subsequent restoration:

THIS CORNER WAS FIRST ESTABLISHED BY U.S. DEPUTY SURVEYOR NOAH BROOKFIELD IN 1837. A WOOD POST WAS SET WITNESSED BY A: 6" MAPLE S 62° W 11 LINKS AND A 8" MAPLE S 79° E 25 LINKS. THERE IS NO RECORDED COUNTY SURVEY INFORMATION RECORDED FOR I-10 THE IONIA COUNTY ROAD COMMISSION PAVED A PORTION OF INGALLS ROAD. NO PLANS COULD BE FOUND. PROFESSIONAL SURVEYOR BURT WICKHAM NO. 17639 RECORDED I-10 MARCH 24, 1987 FOUND IN LIBER 2 PAGE 276 OF RECORDED CORNERS. WICKHAM SAID HE ESTABLISHED I-10 BY INTERSECTING THE NORTH-SOUTH FENCE AND THE CENTERLINE OF INGALLS ROAD AND SET A RAILROAD SPIKE.

B. Description of corner evidence found and/or method applied in restoring or reestablishing corner:


FOUND A RAILROAD SPIKE IN THE SURFACE OF THE BITUMINOUS ROAD (INGALLS ROAD) OPPOSITE AN ESTABLISHED FENCE AND TREE ROW TO THE SOUTH. EXCAVATED ROAD TO A DEPTH OF 36" BUT FOUND NO OTHER EVIDENCE. ACCEPTED THIS POSITION AS THE BEST AVAILABLE EVIDENCE OF THE ORIGINAL CORNER.

C. Description of monument for corner and accessories established to perpetuate locating the position of the corner:

SET A 30" ALUMINUM MONUMENT WITH A 4" DIAMETER CAP STAMPED " IONIA COUNTY 25863" IN PLACE OF THE RAIL ROAD SPIKE. WITNESSED BY:
 NAIL & TAG EAST SIDE 8" HICKORY S 20° W 32.67 FEET
 NAIL & TAG EAST SIDE 42" MAPLE N 20° E 27.2 FEET
 NAIL & TAG SOUTH SIDE 42" MAPLE N 72° E 62.77 FEET
 P.K. NAIL & TAG SOUTH EAST SIDE POWER POLE S 54° W 68.54 FEET

Ratified by Peer Group
 P.A. 345 Ionia County

Date 9-26-96
 Marinus A. Mulder, Chairman

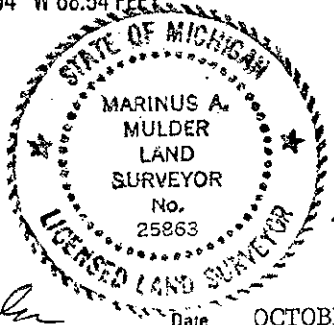

Signed by Marinus A. Mulder Date OCTOBER 22, 1996

Surveyor's Michigan License No. 25863