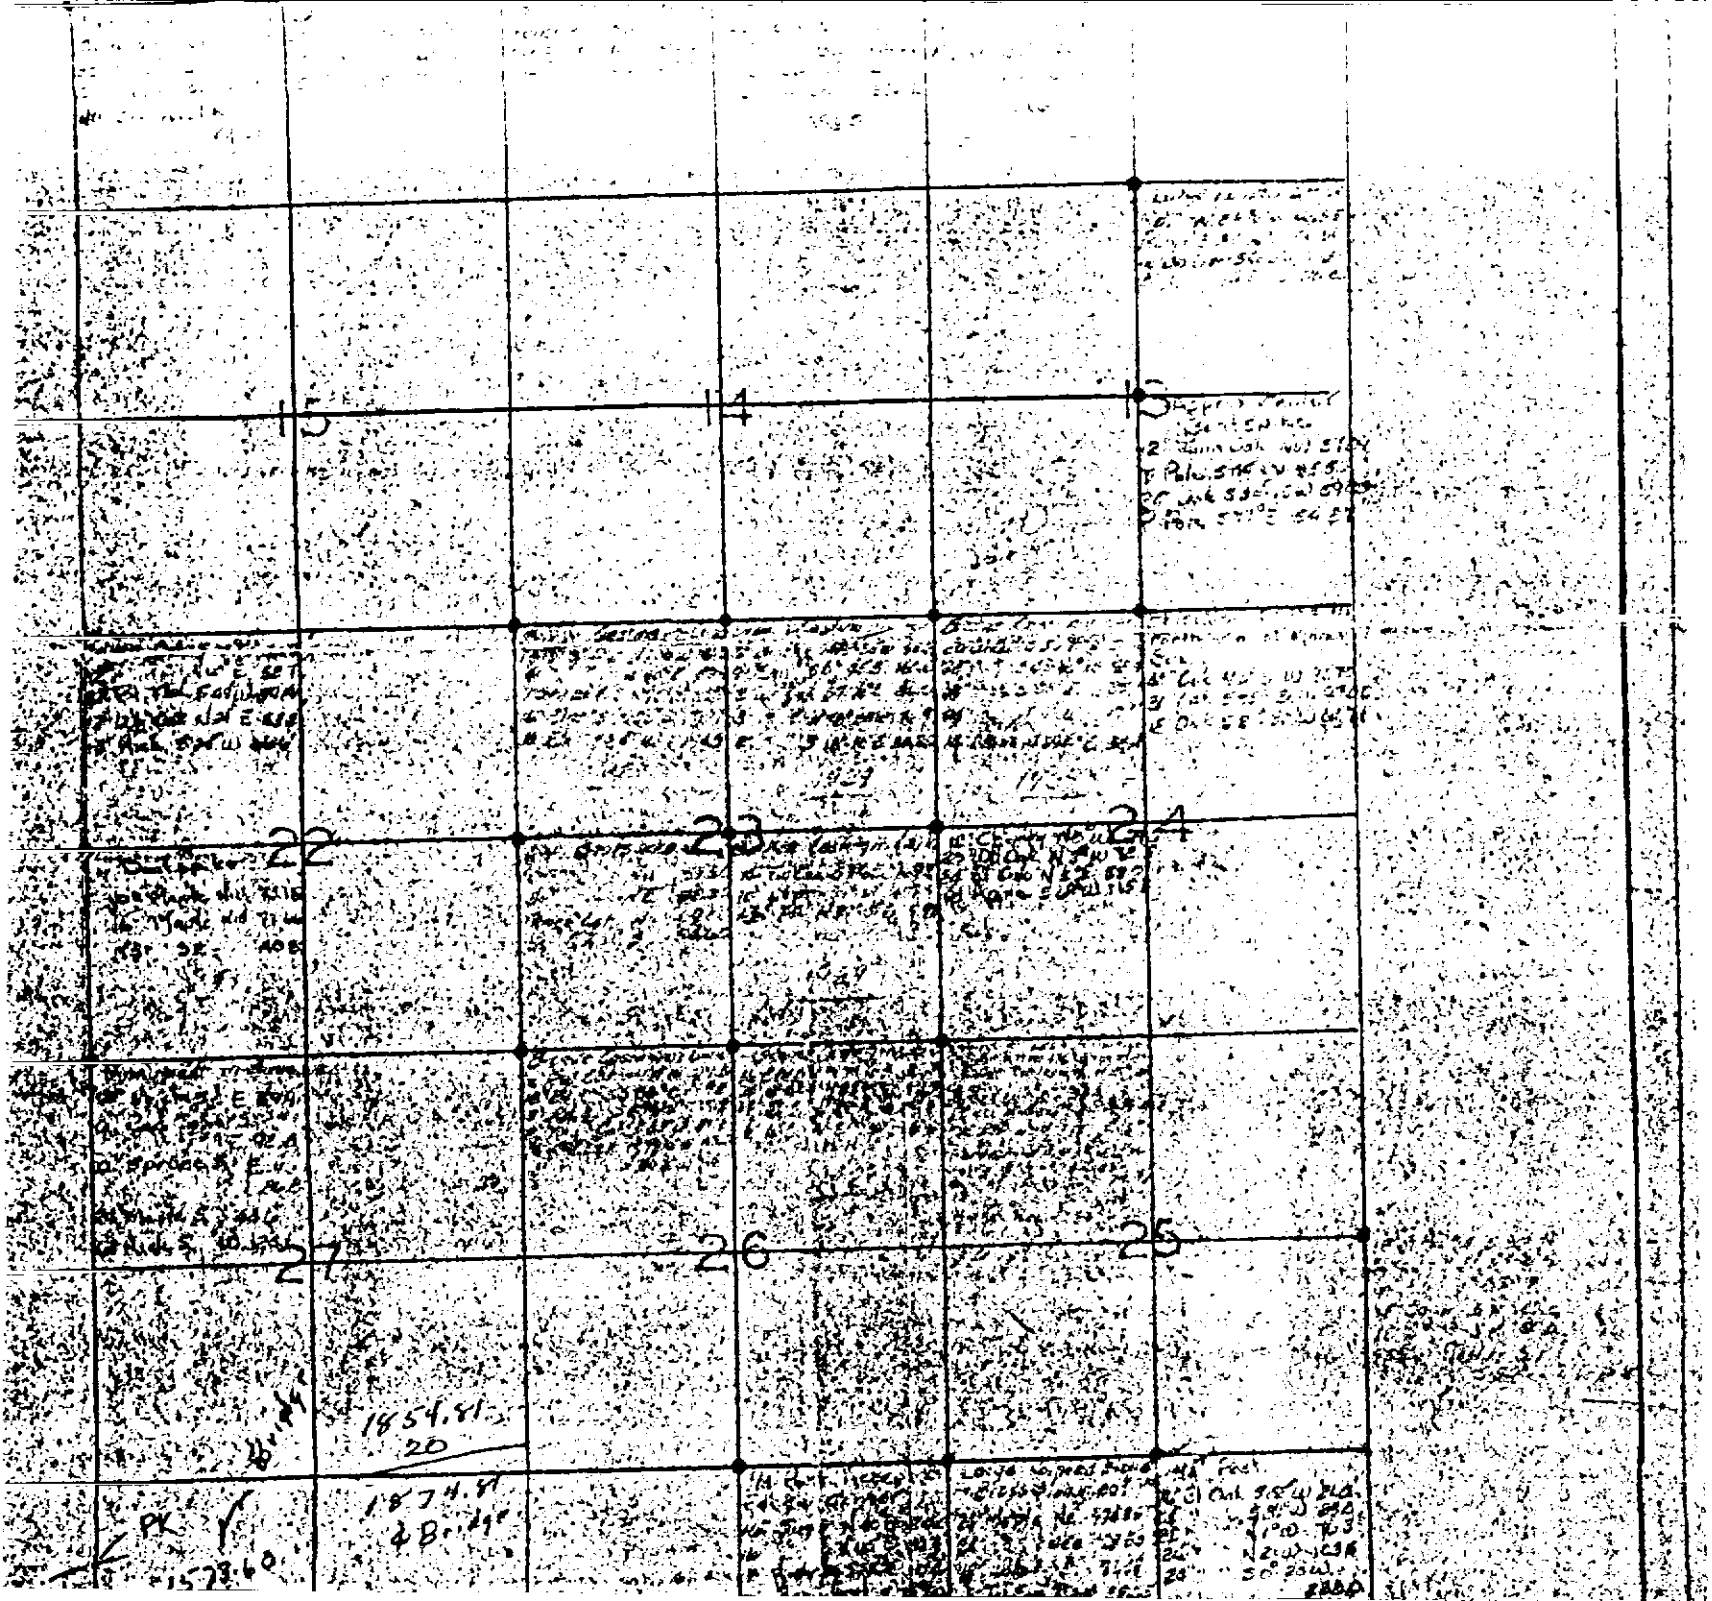
13
14
15
22
23
24
27
26
25
1854.81
20
1874.81
4 Br. dge
PK
1573.60