SURVEY & REMONUMENTATION

MAR 1 8 1998

SECTION

REMONUMENTATION CORNER
LAND CORNER RECORDATION CERTIFICATE
Filing Requirement of Act 74, Mich. P.A. 1970

STATE OF MICHIGAN
IOSCO COUNTY
FILED

3 DEC 97 11:47 A.M.

BONITA M. COYLE
REGISTER OF DEEDS

97-41

Register of Deeds Stamp & File Number

For corners in

Iosco (County)

	Located In:	Corner Code #
1. Public Land Survey	T22N R7E	A-13
	T22N R6E	M-13
	T21N R6E	M-1
	T21N R7E	A-1
2. Property Controlling	S___ T___ R___	
in Section	S___ T___ R___	
3. Miscellaneous	S___ T___ R___	
Property in Sec.	S___ T___ R___	

4. Lot No. _____, Recorded Plat _____
5. Private Claims _____

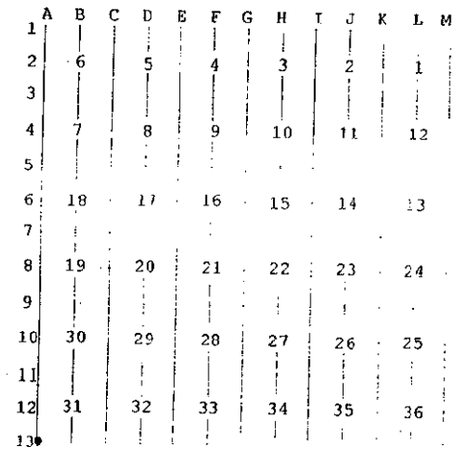

I, James H. Granger, in a field survey on August 4, 19 97 do hereby state that under requirements of P.A. 74, Michigan P.A. of 1970, the corner points mentioned in lines 1 and 2 above were in conformance with regulations and rules therefore as required in the current manual of survey instructions of the United States Department of the Interior, Bureau of Land Management or by a decree of a Court of Law and /or that the corner points mentioned in lines 3, 4 and 5 above were in conformance with the rules of the Michigan Board of Land Surveyors or by a Decree of a Court of Law; established, re-established, monumented, recovered, found as expressed below:

NOTE: Not more than 2 corners, all in the same town and range, may be recorded on this certificate.

A. Description of original monument and accessories and/or subsequent restoration:
1838 GLO Louis Clason Set Wood Post

12" Hemlock	S34°W	22 LKS
12" Hemlock	N44°E	28 LKS

B. Description of corner evidence found and/or method applied in restoring or reestablishing corner:

FD 5/8" Round Head Iron Pin. Single proportionate measurement to SE Cor. of Sec 31 fits acceptably. Accept position as previously established.

ACCEPTED BY THE IOSCO COUNTY SURVEY PEER GROUP AS THE OFFICIAL CORNER UNDER P.A. 345 OF 1990 AT A MEETING HELD ON 9-16-97

James H Granger

C. Description of monument for corner and accessories established to perpetuate locating the position of the corner:
Set 5/8" rebar with Remon Cap in Mon Box.

Utility Pole	N45°E	52.02'	nail & tag 16041
Utility Pole	S51°E	48.74'	nail & tag 16041
12" Aspen	S 4°E	38.00'	nail & tag 16041
22" Aspen	S70°W	86.92'	nail & tag 16041

STATE OF MICHIGAN
JAMES H. GRANGER
PROFESSIONAL SURVEYOR
No. 16041
LICENSED PROFESSIONAL SURVEYOR

Signed by James H Granger

Date November 10, 1997

Surveyor's Michigan License No. 16041

FORM APPROVED BY MICHIGAN STATE BOARD OF PROFESSIONAL SURVEYORS, JAN. 28, 1971
REVISED MAY 14,1975

REVISED JAN., 1983
REVISED OCT., 1995