

**SURVEY & REMONUMENTATION**

**FEB 15 2001**


**IOSCO COUNTY REMONUMENTATION  
LAND CORNER RECORDATION CERTIFICATE  
Filing Requirement of Act 74, Mich. P.A. 1970**

For corners in **SECTION**

**057 2000**

Iosco Located In: \_\_\_\_\_ Corner Code # \_\_\_\_\_  
(County)

- |                                    |         |                  |       |
|------------------------------------|---------|------------------|-------|
| 1. Public Land Survey              |         | T <u>21NR 6E</u> | M-6   |
|                                    |         | T <u>21NR 7E</u> | A-6 ✓ |
|                                    |         | T _____ R _____  | _____ |
|                                    |         | T _____ R _____  | _____ |
| 2. Property Controlling in Section | S _____ | T _____ R _____  | _____ |
|                                    | S _____ | T _____ R _____  | _____ |
| 3. Miscellaneous Property in Sec.  | S _____ | T _____ R _____  | _____ |
|                                    | S _____ | T _____ R _____  | _____ |

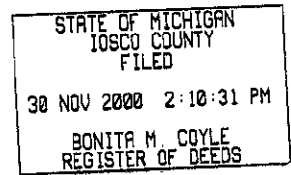

Register of Deeds Stamp & File Number

4. Lot No. \_\_\_\_\_, Recorded Plat \_\_\_\_\_
5. Private Claims \_\_\_\_\_

	A	B	C	D	E	F	G	H	I	J	K	L	M
1													
2	6		5		4		3		2		1		
3													
4	7		8		9		10		11		12		
5													
6	18		17		16		15		14		13		
7													
8	19		20		21		22		23		24		
9													
10	30		29		28		27		26		25		
11													
12	31		32		33		34		35		36		
13													

I, JAMES H. GRANGER, in a field survey on November, 1999 do hereby state that under requirements of P.A. 74, Michigan P.A. of 1970, the corner points mentioned in lines 1 and 2 above were in conformance with regulations and rules therefore as required in the current manual of survey instructions of the United States Department of the Interior, Bureau of Land Management or by a decree of a Court of Law and /or that the corner points mentioned in lines 3, 4 and 5 above were in conformance with the rules of the Michigan Board of Land Surveyors or by a Decree of a Court of Law; established, re-established, monumented, recovered, found as expressed below:

**NOTE: Not more than 2 corners, all in the same town and range, may be recorded on this certificate.**

**A. Description of original monument and accessories and/or subsequent restoration:**

1837 GLO	Set Wood Post	
Lewis Clawson	7" S. Maple	S24°W 10lks
	5" S. Maple	N37°W 20lks

**B. Description of corner evidence found and/or method applied in restoring or reestablishing corner:**

Measured distance & established Township line from SE cor. Sec. 13 to NE cor. Sec. 12. Established NE cor. Sec. 13 halfway & on-line. Established E1/4 cor. halfway & on-line between SE & NE Sec. corners. No original evidence found. Accepted position as determined by single proportionate measurement between NE & SE Sec. corners.


**C. Description of monument for corner and accessories established to perpetuate locating the position of the corner:**

5/8" x 30" rebar w/ Remon Cap		
14" Ash	S25°E	25.98' nail & tag 16041
16" Soft Maple	S86°E	35.96' nail & cap 16041
Dlb. Maple	S46°E	13.45' nail & cap 16041
16" Maple Stump	N15°E	26.35' nail & cap 16041

Replaces LCRC filed as L99, P49

ACCEPTED BY THE IOSCO COUNTY SURVEY PEER GROUP AS THE OFFICIAL CORNER UNDER P.A. 345 OF 1990 AT A MEETING HELD ON 10-13-99

*James H. Granger*

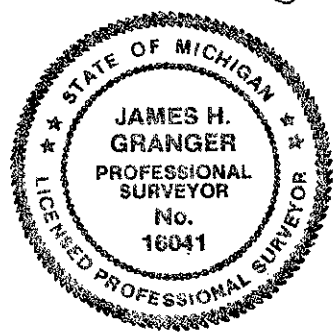

Signed by James H. Granger  
Surveyor's Michigan License No. 16041

Date NOV. 29, 2000