

**IOSCO COUNTY REMONUMENTATION  
LAND CORNER RECORDATION CERTIFICATE  
Filing Requirement of Act 74, Mich. P.A. 1970**

99-51

For corners in

<u>iosco</u> (County)	Located In:	Corner Code #
1. Public Land Survey	T <u>21NR 6E</u>	M-8 <i>W. Mullen</i>
	T <u>21NR 7E</u>	A-8 <i>W. Mullen</i>
	T ___ R ___	___
	T ___ R ___	___
2. Property Controlling in Section	S ___ T ___ R ___	___
	S ___ T ___ R ___	___
3. Miscellaneous Property in Sec.	S ___ T ___ R ___	___
	S ___ T ___ R ___	___

STATE OF MICHIGAN  
IOSCO COUNTY  
FILED

20 DEC 99 10:15 A.M.

RONITA M. COYLE  
REGISTER OF DEEDS

Register of Deeds Stamp & File Number

4. Lot No. \_\_\_\_\_, Recorded Plat \_\_\_\_\_

5. Private Claims \_\_\_\_\_

	A	B	C	D	E	F	G	H	I	J	K	L	M
1													
2	6		5		4			3		2		1	
3													
4	7		8		9			10		11		12	
5													
6	18		17		16			15		14		13	
7													
8	19		20		21			22		23		24	
9													
10	30		29		28			27		26		25	
11													
12	31		32		33			34		35		36	
13													

I, JAMES H. GRANGER, in a field survey on November, 1999 do hereby state that under requirements of P.A. 74, Michigan P.A. of 1970, the corner points mentioned in lines 1 and 2 above were in conformance with regulations and rules therefore as required in the current manual of survey instructions of the United States Department of the Interior, Bureau of Land Management or by a decree of a Court of Law and for that the corner points mentioned in lines 3, 4 and 5 above were in conformance with the rules of the Michigan Board of Land Surveyors or by a Decree of a Court of Law; established, re-established, monumented, recovered, found as expressed below:

**NOTE: Not more than 2 corners, all in the same town and range, may be recorded on this certificate.**

**A. Description of original monument and accessories and/or subsequent restoration:**

1837 GLO                      Set Wood Post  
Lewis Clawson              9" B. Ash                      S32°W 17lks  
   6" Cedar                      N28°W 36lks

1998 Survey                      Set corner & 4 witnesses  
James H. Granger 16041

**B. Description of corner evidence found and/or method applied in restoring or reestablishing corner:**


Found 1998 corner marker. Found 1914 survey documents on Mc Mullen Drain showing corner to be on W. side of Drain. 1998 corner on E. side of Drain. No original evidence found at either location due to Drain constr. With no other documentation available and considering parol evidence of long time property owners, it was concluded that corner position is on W. side of Drain. Measured S. from NE cor. using data from 1914 Drain survey to establish corner position.

**C. Description of monument for corner and accessories established to perpetuate locating the position of the corner:**

5/8" x 30" rebar w/ Remon Cap  
Post                      N65 E                      22.55' nail & tag 16041  
4" Cedar Post              S5 W                      34.78' nail & cap 16041  
14" B. Ash                      S65 E                      65.57' nail & cap 16041  
14" Dbl. B. Ash              N72 E                      93.19' nail & cap 16041  
at east edge of Mc Mullen Drain

ACCEPTED BY THE IOSCO COUNTY  
SURVEY PEER GROUP AS THE  
OFFICIAL CORNER UNDER P.A.  
345 OF 1990 AT A MEETING  
HELD ON 10-13-99

*James H. Granger*

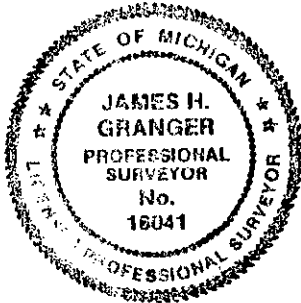

Signed by James H. Granger Date December 15, 1999  
Surveyor's Michigan License No. 16041

REF  
APR 27 2000  
SECTION