

**IOSCO COUNTY REMONUMENTATION  
LAND CORNER RECORDATION CERTIFICATE  
Filing Requirement of Act 74, Mich. P.A. 1970**

99-52

For corners in

STATE OF MICHIGAN  
IOSCO COUNTY  
FILED

20 DEC 99 10:13 A.M.

SONITA M. COYLE  
REGISTER OF DEEDS

<u>iosco</u> (County)	Located In:	Corner Code #
1. Public Land Survey	T 21NR 6E T 21NR 7E T ___ R ___ T ___ R ___	M-9 A-9
2. Property Controlling in Section	S ___ T ___ R ___ S ___ T ___ R ___	
3. Miscellaneous Property in Sec.	S ___ T ___ R ___ S ___ T ___ R ___	

Register of Deeds Stamp & File Number

4. Lot No. \_\_\_\_\_, Recorded Plat \_\_\_\_\_  
5. Private Claims \_\_\_\_\_

	A	B	C	D	E	F	G	H	I	J	K	L	M
1													
2	6		5		4		3		2		1		
3													
4	7		8		9		10		11		12		
5													
6	18		17		16		15		14		13		
7													
8	19		20		21		22		23		24		
9													
10	30		29		28		27		26		25		
11													
12	31		32		33		34		35		36		
13													

I, JAMES H. GRANGER, in a field survey on November, 1999 do hereby state that under requirements of P.A. 74, Michigan P.A. of 1970, the corner points mentioned in lines 1 and 2 above were in conformance with regulations and rules therefore as required in the current manual of survey instructions of the United States Department of the Interior, Bureau of Land Management or by a decree of a Court of Law and for that the corner points mentioned in lines 3, 4 and 5 above were in conformance with the rules of the Michigan Board of Land Surveyors or by a Decree of a Court of Law; established, re-established, monumented, recovered, found as expressed below:

**NOTE: Not more than 2 corners, all in the same town and range, may be recorded on this certificate.**

A. Description of original monument and accessories and/or subsequent restoration:

1837 GLO	Set Wood Post	
Lewis Clawson	16" Spruce	S85°W 8lks
	7" Cedar	N59°W 16lks

1998 Survey Set corner & 4 witnesses  
James H. Granger 16041

B. Description of corner evidence found and/or method applied in restoring or reestablishing corner:


Found 1998 corner marker. Found 1914 survey documents on Mc Mullen Drain showing corner to be on W. side of Drain. 1998 corner on E. side of Drain. No original evidence found at either location due to Drain constr. With no other documentation available and considering parcel evidence of long time property owners, it was concluded that corner position is on W. side of Drain. Measured S. from E1/4 cor. using data from 1914 Drain survey to establish corner position.

C. Description of monument for corner and accessories established to perpetuate locating the position of the corner:

5/8" x 30" rebar w/ Remon Cap		
Cedar Post	N59°W	14.05' nail & tag 16041
6" Ash	N35°E	55.08' nail & cap 16041
5" Ash	S38°W	65.25' nail & cap 16041
4" Dbl. Ash	S83°W	54.68' nail & cap 16041

ACCEPTED BY THE IOSCO COUNTY  
SURVEY FIELD GROUP AS THE  
OFFICIAL CORNER UNDER P.A.  
815 OF 1900 AT A MEETING  
HELD ON 10-13-99

*James H. Granger*

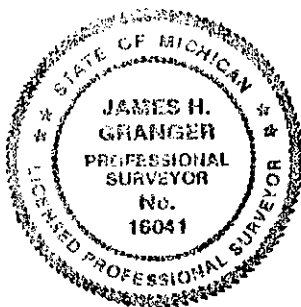

Signed by James H. Granger  
Surveyor's Michigan License No. 16041

Date December 15, 1999

REA

APR 20 2000

SECTION