

**IOSCO COUNTY REMONUMENTATION
LAND CORNER RECORDATION CERTIFICATE
Filing Requirement of Act 74, Mich. P.A. 1970**

99-56

For corners in

<u>Iosco</u> (County)	Located In:	Corner Code #
1. Public Land Survey	T 21NR 6E T 21NR 7E T R T R	M-13 A-13
2. Property Controlling in Section	S T R S T R	
3. Miscellaneous Property in Sec.	S T R S T R	
4. Lot No. _____, Recorded Plat _____		
5. Private Claims _____		

STATE OF MICHIGAN
IOSCO COUNTY
FILED
20 DEC 99 10:14 A.M.
RONITA M. COYLE
REGISTER OF DEEDS

Register of Deeds Stamp & File Number

	A	B	C	D	E	F	G	H	I	J	K	L	M
1													
2	6		5		4			3		2			1
3													
4	7		8		9			10		11			12
5													
6	18		17		16			15		14			13
7													
8	19		20		21			22		23			24
9													
10	30		29		28			27		26			25
11													
12	31		32		33			34		35			36
13													

I, JAMES H. GRANGER, in a field survey on November, 1999 do hereby state that under requirements of P.A. 74, Michigan P.A. of 1970, the corner points mentioned in lines 1 and 2 above were in conformance with regulations and rules therefore as required in the current manual of survey instructions of the United States Department of the Interior, Bureau of Land Management or by a decree of a Court of Law and /or that the corner points mentioned in lines 3, 4 and 5 above were in conformance with the rules of the Michigan Board of Land Surveyors or by a Decree of a Court of Law, established, re-established, monumented, recovered, found as expressed below:

NOTE: Not more than 2 corners, all in the same town and range, may be recorded on this certificate.

A. Description of original monument and accessories and/or subsequent restoration:

1837 GLO	Set Wood Post	
Lewis Clawson	7" B. Ash	N64°W 30lks
	15" B. Ash	N4°E 36lks

B. Description of corner evidence found and/or method applied in restoring or reestablishing corner:


Extended S. line of T21N, R7E west from Sec. 32 west using GLO measurements. Found NE cor. Sec. 4, T20N, R7E & agreed well with GLO distance from SE cor. Sec. 31, T21N, R7E. No original evidence found. Established position as measured. Subsequent work by PS 41108 on S. Township line to the west measured into this corner confirmed the location.

C. Description of monument for corner and accessories established to perpetuate locating the position of the corner:

5/8" x 30" rebar w/ Remon Cap		
Triple Maple	N5°W	35.95' nail & tag 16041
Double Maple	N57°W	10.53' nail & cap 16041
Triple Maple	S1°E	30.99' nail & cap 16041
14" Ash	N85°E	53.29' nail & cap 16041

ACCEPTED BY THE IOSCO COUNTY
SURVEY PEER GROUP AS THE
OFFICIAL CORNER UNDER P.A.
345 OF 1990 AT A MEETING
HELD ON 10-13-99

James H. Granger

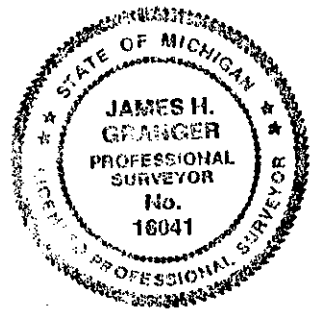

Signed by James H. Granger
Surveyor's Michigan License No. 16041

Date December 15, 1999

RFR

APR 21 2000

SECTION