

**REMONUMENTATION CORNER
LAND CORNER RECORDATION CERTIFICATE
Filing Requirement of Act 74, Mich. P.A. 1970**

STATE OF MICHIGAN
IOSCO COUNTY
FILED

For corners in

<u>Iosco</u> (County)	Located In:	Corner Code #
1. Public Land Survey	<u>T21N R7E</u>	<u>B-1</u>
	T <u> </u> R <u> </u>	<u> </u>
	T <u> </u> R <u> </u>	<u> </u>
	T <u> </u> R <u> </u>	<u> </u>
2. Property Controlling in Section	S <u> </u> T <u> </u> R <u> </u>	<u> </u>
	S <u> </u> T <u> </u> R <u> </u>	<u> </u>
3. Miscellaneous Property in Sec.	S <u> </u> T <u> </u> R <u> </u>	<u> </u>
	S <u> </u> T <u> </u> R <u> </u>	<u> </u>

3 DEC 97 11:47 A.M.

RONITA M. COYLE
REGISTER OF DEEDS

97-42

Register of Deeds Stamp & File Number

4. Lot No. _____, Recorded Plat _____
5. Private Claims _____

A	B	C	D	E	F	G	H	I	J	K	L	M
1	•											
2	6		5		4		3		2		1	
3												
4	7		8		9		10		11		12	
5												
6	18		17		16		15		14		13	
7												
8	19		20		21		22		23		24	
9												
10	30		29		28		27		26		25	
11												
12	31		32		33		34		35		36	
13												

I, James H. Granger, in a field survey on August 4, 1997 do hereby state that under requirements of P.A. 74, Michigan P.A. of 1970, the corner points mentioned in lines 1 and 2 above were in conformance with regulations and rules therefore as required in the current manual of survey instructions of the United States Department of the Interior, Bureau of Land Management or by a decree of a Court of Law and /or that the corner points mentioned in lines 3, 4 and 5 above were in conformance with the rules of the Michigan Board of Land Surveyors or by a Decree of a Court of Law; established, re-established, monumented, recovered, found as expressed below:

NOTE: Not more than 2 corners, all in the same town and range, may be recorded on this certificate.

A. Description of original monument and accessories and/or subsequent restoration:

No Original GLO Notes

B. Description of corner evidence found and/or method applied in restoring or reestablishing corner:

Nothing found.
Establish position by single proportionate measurement on line between SW and S 1/4 Remon Corners of Section 31, T22N, R7E.


ACCEPTED BY THE IOSCO COUNTY
SURVEY PEER GROUP AS THE
OFFICIAL CORNER UNDER P.A.
345 OF 1990 AT A MEETING
HELD ON 9-16-97

James H. Granger

C. Description of monument for corner and accessories established to perpetuate locating the position of the corner:

Set 5/8" rebar with Remon Cap in Mon Box.

8" Elm	N63°W	59.48'	nail & tag 16041
6" Triple Elm	N20°E	36.45'	nail & tag 16041
Utility Pole	S 9°E	52.56'	nail & tag 16041
6" Aspen	S25°W	44.14'	nail & tag 16041
B-13 Remon Cap in Mon Box East		6.04'	(T22N, R7E)

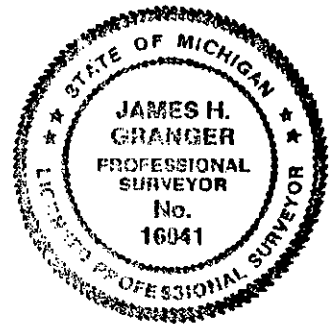

Signed by *James H. Granger*
Surveyor's Michigan License No. 16041

Date November 10, 1997

**SURVEY &
REMONUMENTATION**

MAR 18 1998

SECTION