

**REMONUMENTATION CORNER  
LAND CORNER RECORDATION CERTIFICATE  
Filing Requirement of Act 74, Mich. P.A. 1970**

For corners in

<u>Iosco</u> (County)	Located In:	Corner Code #
1. Public Land Survey	T21N R7E	C-1
	T ___ R ___	___
	T ___ R ___	___
	T ___ R ___	___
2. Property Controlling in Section	S ___ T ___ R ___	___
	S ___ T ___ R ___	___
3. Miscellaneous Property in Sec.	S ___ T ___ R ___	___
	S ___ T ___ R ___	___

STATE OF MICHIGAN  
IOSCO COUNTY  
FILED

3 DEC 97 11:48 A.M.

BONITA M. COYLE  
REGISTER OF DEEDS

**97-44**

Register of Deeds Stamp & File Number

4. Lot No. \_\_\_\_\_, Recorded Plat \_\_\_\_\_  
5. Private Claims \_\_\_\_\_

I, James H. Granger, in a field survey on August 4, 1997 do hereby state that under requirements of P.A. 74, Michigan P.A. of 1970, the corner points mentioned in lines 1 and 2 above were in conformance with regulations and rules therefore as required in the current manual of survey instructions of the United States Department of the Interior, Bureau of Land Management or by a decree of a Court of Law and /or that the corner points mentioned in lines 3, 4 and 5 above were in conformance with the rules of the Michigan Board of Land Surveyors or by a Decree of a Court of Law; established, re-established, monumented, recovered, found as expressed below:

**NOTE: Not more than 2 corners, all in the same town and range, may be recorded on this certificate.**

1	A	B	C	D	E	F	G	H	I	J	K	L	M
2		6		5		4		3		2		1	
3													
4		7		8		9		10		11		12	
5													
6		18		17		16		15		14		13	
7													
8		19		20		21		22		23		24	
9													
10		30		29		28		27		26		25	
11													
12		31		32		33		34		35		36	
13													

A. Description of original monument and accessories and/or subsequent restoration:

1843 GLO James Mullett Set Wood Post  
10" B. Ash S25°E 27 LKS  
8" Maple S44°W 29 LKS  
18 LKS W of SE Cor Sec. 31, T22N, R7E

B. Description of corner evidence found and/or method applied in restoring or reestablishing corner:

FD 1/2" Iron Rod  
Marker fits within 1" of GLO measurement.  
Accept position as previously established.


ACCEPTED BY THE IOSCO COUNTY  
SURVEY PEER GROUP AS THE  
OFFICIAL CORNER UNDER P.A.  
345 OF 1990 AT A MEETING  
HELD ON 9-16-97

*James H. Granger*

C. Description of monument for corner and accessories established to perpetuate locating the position of the corner:

Set 5/8" rebar with Remon Cap in Mon Box.

3" Apple	N24°W	48.36'	nail & tag 16041
3' tall utility pole	S31°E	62.04'	nail & tag 16041
3' fall utility pole	S26°W	38.25'	nail & tag 16041
Road sign	N24°W	48.36'	
C-13 Remon Cap in Mon Box East		11.96'	(T22N, R7E)

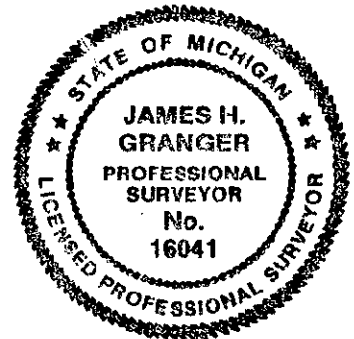

Signed by James H. Granger

Date November 10, 1997

Surveyor's Michigan License No. 16041

**SURVEY &  
REMONUMENTATION**

FORM APPROVED BY MICHIGAN STATE BOARD OF PROFESSIONAL SURVEYORS, JAN. 28, 1971  
REVISED MAY 14, 1975

MAR 18 1998

REVISED JAN., 1983  
REVISED OCT., 1995

SECTION