REMONUMENTATION CORNER
LAND CORNER RECORDATION CERTIFICATE
Filing Requirement of Act 74, Mich. P.A. 1970

For corners in

Iosco (County) — Located In: — Corner Code #

1. Public Land Survey		T21N R7E	D-1
		T___ R___	
		T___ R___	
		T___ R___	
2. Property Controlling	S___	T___ R___	
in Section	S___	T___ R___	
3. Miscellaneous	S___	T___ R___	
Property in Sec.	S___	T___ R___	

STATE OF MICHIGAN
IOSCO COUNTY
FILED

3 DEC 97 11:48 A.M.

RONITA M. COYLE
REGISTER OF DEEDS

97-46
Register of Deeds Stamp & File Number

4. Lot No. _____ , Recorded Plat _____
5. Private Claims _____

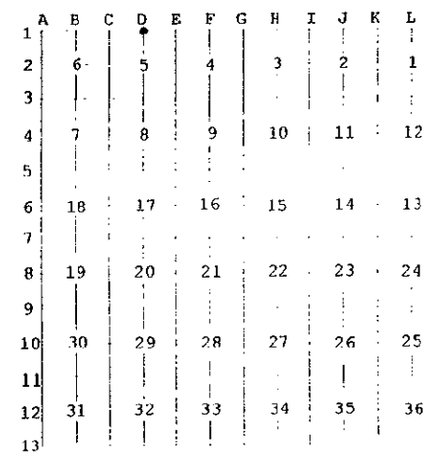

I, James H. Granger, in a field survey on August 4, 1997 do hereby state that under requirements of P.A. 74, Michigan P.A. of 1970, the corner points mentioned in lines 1 and 2 above were in conformance with regulations and rules therefore as required in the current manual of survey instructions of the United States Department of the Interior, Bureau of Land Management or by a decree of a Court of Law and /or that the corner points mentioned in lines 3, 4 and 5 above were in conformance with the rules of the Michigan Board of Land Surveyors or by a Decree of a Court of Law; established, re-established, monumented, recovered, found as expressed below:

NOTE: Not more than 2 corners, all in the same town and range, may be recorded on this certificate.

A. Description of original monument and accessories and/or subsequent restoration:

No original GLO notes

B. Description of corner evidence found and/or method applied in restoring or reestablishing corner:

Found 1/2" pipe by Campbell for S 1/4 Sec. 32, T22N, R7E
Established position by single proportionate distance between
SW & S 1/4 corners of Sec. 32, T22N, R7E

ACCEPTED BY THE IOSCO COUNTY SURVEY PEER GROUP AS THE OFFICIAL CORNER UNDER P.A. 345 OF 1990 AT A MEETING HELD ON 9-16-97
James H Granger

C. Description of monument for corner and accessories established to perpetuate locating the position of the corner:

Set 5/8" rebar with Remon Cap in Mon Box.

30" Quad maple	N18°E	47.68'	nail & tag 16041
3" Red pine	S17°E	33.58'	nail & tag 16041
2' tall utility pole	S30°W	36.56'	nail & tag 16041
Utility pole	N23°W	50.01'	nail & tag 16041
Campbell 1/2" pipe	West	18.07'	
D-13 Remon Cap in Mon Box	East	9.35'	(T22N, R7E)

STATE OF MICHIGAN
JAMES H. GRANGER
PROFESSIONAL SURVEYOR
No. 16041
LICENSED PROFESSIONAL SURVEYOR

Signed by James H Granger
Surveyor's Michigan License No. 16041

Date November 10, 1997

FORM APPROVED BY MICHIGAN STATE BOARD OF PROFESSIONAL SURVEYORS, JAN. 28, 1971
REVISED MAY 14,1975
REVISED JAN., 1983
REVISED OCT., 1995

SURVEY &
REMONUMENTATION

MAR 18 1998

SECTION