

**REMONUMENTATION CORNER
LAND CORNER RECORDATION CERTIFICATE**
Filing Requirement of Act 74, Mich. P.A. 1970

For corners in

Iosco	Located In:	Corner Code #
<small>(County)</small>		
1. Public Land Survey	T21N R7E	E-7
	T___ R___	_____
	T___ R___	_____
	T___ R___	_____
2. Property Controlling in Section	S___ T___ R___	_____
	S___ T___ R___	_____
3. Miscellaneous Property in Sec.	S___ T___ R___	_____
	S___ T___ R___	_____

STATE OF MICHIGAN
IOSCO COUNTY
FILED

3 DEC 97 11:51 A.M.

RONITA M. COYLE
REGISTER OF DEEDS

97-62

Register of Deeds Stamp & File Number

4. Lot No. _____, Recorded Plat _____
5. Private Claims _____

A	B	C	D	E	F	G	H	I	J	K	L	M
1												
2	6		5		4			3		2		1
3												
4	7		8		9			10		11		12
5												
6	18		17		16			15		14		13
7												
8	19		20		21			22		23		24
9												
10	30		29		28			27		26		25
11												
12	31		32		33			34		35		36
13												

I, James H. Granger, in a field survey on August 12, 1997 do hereby state that under requirements of P.A. 74, Michigan P.A. of 1970, the corner points mentioned in lines 1 and 2 above were in conformance with regulations and rules therefore as required in the current manual of survey instructions of the United States Department of the Interior, Bureau of Land Management or by a decree of a Court of Law and/or that the corner points mentioned in lines 3, 4 and 5 above were in conformance with the rules of the Michigan Board of Land Surveyors or by a Decree of a Court of Law; established, re-established, monumented, recovered, found as expressed below:

NOTE: Not more than 2 corners, all in the same town and range, may be recorded on this certificate.

A. Description of original monument and accessories and/or subsequent restoration:

1843	GLO	James Mullett	Set wood post	witnesses		
			8" Spruce	N45°E	25LKS	
1996		James H. Granger #16041	6" Tamarack	S30°W	57LKS	
			Iron in mon box.			

B. Description of corner evidence found and/or method applied in restoring or reestablishing corner:

Found 3/4" pipe with large spike in Mon Box.
Accept position as previously established.
Unable to remove spike or pipe. Road Commission welded 5/8" on end of pipe.


ACCEPTED BY THE IOSCO COUNTY
SURVEY PEER GROUP AS THE
OFFICIAL CORNER UNDER P.A.
345 OF 1990 AT A MEETING
HELD ON 9-16-97

James H. Granger

C. Description of monument for corner and accessories established to perpetuate locating the position of the corner:

Welded 5/8" Rebar on 3/4" pipe with Remon Cap in Mon Box

3" W. Pine	S56°W	61.67'	nail & tag 16041
24" Twin Pine	S 9°E	39.87'	nail & tag 16041
Utility Pole	N61°E	53.00'	nail & tag 16041
4" Red Pine	N47°W	62.55'	nail & tag 16041

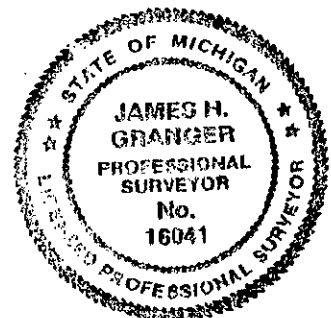

Signed by James H. Granger
Surveyor's Michigan License No. 16041

Date Nov. 10, 1997

FORM APPROVED BY MICHIGAN STATE BOARD OF PROFESSIONAL SURVEYORS, JAN. 28, 1971
REVISED MAY 14, 1975

REVISED JAN., 1983
REVISED OCT., 1995

**SURVEY &
REMONUMENTATION**

MAR 18 1998

SECTION