

**REMONUMENTATION CORNER
LAND CORNER RECORDATION CERTIFICATE
Filing Requirement of Act 74, Mich. P.A. 1970**

For corners in

Iosco Located In: Corner Code #
(County)

1. Public Land Survey T21N R7E F-7
T__ R__
T__ R__
T__ R__

2. Property Controlling S__ T__ R__
in Section S__ T__ R__

3. Miscellaneous S__ T__ R__
Property in Sec. S__ T__ R__

STATE OF MICHIGAN
IOSCO COUNTY
FILED

3 DEC 97 11:52 A.M.

RONITA H. COYLE
REGISTER OF DEEDS

97-63

Register of Deeds Stamp & File Number

4. Lot No. _____, Recorded Plat _____
5. Private Claims _____

I, James H. Granger, in a field survey on August 12, 1997 do hereby state that under requirements of P.A. 74, Michigan P.A. of 1970, the corner points mentioned in lines 1 and 2 above were in conformance with regulations and rules therefore as required in the current manual of survey instructions of the United States Department of the Interior, Bureau of Land Management or by a decree of a Court of Law and /or that the corner points mentioned in lines 3, 4 and 5 above were in conformance with the rules of the Michigan Board of Land Surveyors or by a Decree of a Court of Law; established, re-established, monumented, recovered, found as expressed below:

NOTE: Not more than 2 corners, all in the same town and range, may be recorded on this certificate.

	A	B	C	D	E	F	G	H	I	J	K	L	M
1													
2		6		5		4		3		2		1	
3													
4		7		8		9		10		11		12	
5													
6		18		17		16		15		14		13	
7													
8		19		20		21		22		23		24	
9													
10		30		29		28		27		26		25	
11													
12		31		32		33		34		35		36	
13													

A. Description of original monument and accessories and/or subsequent restoration:

1843 GLO James Mullett Set wood post
(need witnesses)

B. Description of corner evidence found and/or method applied in restoring or reestablishing corner:

No evidence of original corner.
Establish position by single proportionate measurement on line between SW and SE Sec. Corners. Road Commission rebuilt road and marked position with 1/2" rebar in mon box.


ACCEPTED BY THE IOSCO COUNTY
SURVEY PEER GROUP AS THE
OFFICIAL CORNER UNDER P.A.
345 OF 1990 AT A MEETING
HELD ON 9-16-97

James H. Granger

C. Description of monument for corner and accessories established to perpetuate locating the position of the corner:

Set 5/8" Rebar with Remon Cap in Mon Box

14" Red Pine	N43°W	65.85'	nail & tag 16041
Utility Pole	North	29.05'	nail & tag 16041
4" Aspen	S13°E	37.13'	nail & tag 16041
6" Red Pine	S69°W	147.80'	nail & tag 16041

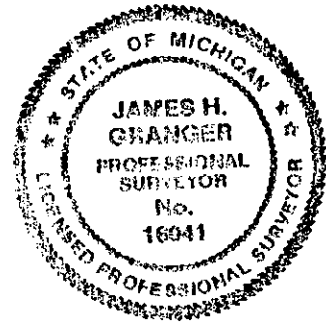

Signed by James H. Granger
Surveyor's Michigan License No. 16041

Date Nov. 10, 1997

FORM APPROVED BY MICHIGAN STATE BOARD OF PROFESSIONAL SURVEYORS, JAN. 28, 1971
REVISED MAY 14, 1975

REVISED JAN., 1983
REVISED OCT., 1995

**SURVEY &
REMONUMENTATION**

MAR 18 1998

SECTION