

**REMONUMENTATION CORNER  
LAND CORNER RECORDATION CERTIFICATE  
Filing Requirement of Act 74, Mich. P.A. 1970**

STATE OF MICHIGAN  
IOSCO COUNTY  
FILED

3 DEC 97 11:49 A.M.

RONITA M. COYLE  
REGISTER OF DEEDS

**97-52**

Register of Deeds Stamp & File Number

For corners in

<u>Iosco</u> (County)	Located In:	Corner Code #
1. Public Land Survey	T21N R7E	G-1
	T___ R___	_____
	T___ R___	_____
	T___ R___	_____
2. Property Controlling in Section	S___ T___ R___	_____
	S___ T___ R___	_____
3. Miscellaneous Property in Sec.	S___ T___ R___	_____
	S___ T___ R___	_____

4. Lot No. \_\_\_\_\_, Recorded Plat \_\_\_\_\_  
5. Private Claims \_\_\_\_\_

I, James H. Granger, in a field survey on August 4, 1997 do hereby state that under requirements of P.A. 74, Michigan P.A. of 1970, the corner points mentioned in lines 1 and 2 above were in conformance with regulations and rules therefore as required in the current manual of survey instructions of the United States Department of the Interior, Bureau of Land Management or by a decree of a Court of Law and /or that the corner points mentioned in lines 3, 4 and 5 above were in conformance with the rules of the Michigan Board of Land Surveyors or by a Decree of a Court of Law; established, re-established, monumented, recovered, found as expressed below:

**NOTE: Not more than 2 corners, all in the same town and range, may be recorded on this certificate.**

A	B	C	D	E	F	G	H	I	J	K	L	M
1												
2	6		5		4		3		2		1	
3												
4	7		8		9		10		11		12	
5												
6	18		17		16		15		14		13	
7												
8	19		20		21		22		23		24	
9												
10	30		29		28		27		26		25	
11												
12	31		32		33		34		35		36	
13												

- A. Description of original monument and accessories and/or subsequent restoration:
- 1843 GLO James Mullett Set wood post 12" Maple S22°W 37LKS  
12" Maple S49°E 21LKS  
26 LKS W. of SE cor, Sec. 33, T22N, R7E
  - 1973 James Campbell #15397 Plow Point


B. Description of corner evidence found and/or method applied in restoring or reestablishing corner:  
Found "T" Iron. No witnesses. Marker lies within 0.02' of GLO distance from the SE cor Sec. 33, T22N, on line between SE Cor and S 1/4 Cor. Sec. 33, T22N, R7E.  
Accept position as previously established.

ACCEPTED BY THE IOSCO COUNTY  
SURVEY PEER GROUP AS THE  
OFFICIAL CORNER UNDER P.A.  
345 OF 1990 AT A MEETING  
HELD ON 9-16-97

*James H. Granger*

C. Description of monument for corner and accessories established to perpetuate locating the position of the corner:

- Set 5/8" rebar with Remon Cap in Mon Box.
- 3" Oak N37°E 70.16' nail & tag 16041
- 5" Box Elder S49°E 66.15' nail & tag 16041
- Utility Pole S33°W 44.39' nail & tag 16041
- 20" Cottonwood S40°W 82.31' nail & tag 16041
- G-13 Remon Cap in Mon Box East 17.14' (T22N, R7E)

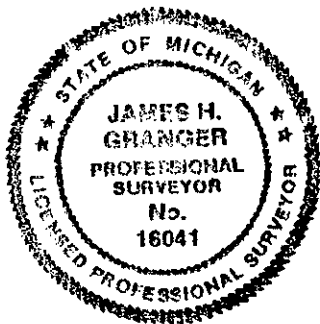

Signed by James H. Granger  
Surveyor's Michigan License No. 16041

Date November 10, 1997

**SURVEY &  
REMONUMENTATION**

MAR-18-1998

SECTION