

**REMONUMENTATION CORNER
LAND CORNER RECORDATION CERTIFICATE
Filing Requirement of Act 74, Mich. P.A. 1970**

STATE OF MICHIGAN
IOSCO COUNTY
FILED

3 DEC 97 11:52 A.M.

RONITA M. COYLE
REGISTER OF DEEDS

97-64

Register of Deeds Stamp & File Number

For corners in

<u>Iosco</u> (County)	Located In:	Corner Code #
1. Public Land Survey	T21N R7E	G-7
	T___ R___	_____
	T___ R___	_____
	T___ R___	_____
2. Property Controlling in Section	S___ T___ R___	_____
	S___ T___ R___	_____
3. Miscellaneous Property in Sec.	S___ T___ R___	_____
	S___ T___ R___	_____

4. Lot No. _____, Recorded Plat _____
5. Private Claims _____

I, James H. Granger, in a field survey on August 12, 1997 do hereby state that under requirements of P.A. 74, Michigan P.A. of 1970, the corner points mentioned in lines 1 and 2 above were in conformance with regulations and rules therefore as required in the current manual of survey instructions of the United States Department of the Interior, Bureau of Land Management or by a decree of a Court of Law and for that the corner points mentioned in lines 3, 4 and 5 above were in conformance with the rules of the Michigan Board of Land Surveyors or by a Decree of a Court of Law; established, re-established, monumented, recovered, found as expressed below:

NOTE: Not more than 2 corners, all in the same town and range, may be recorded on this certificate.

1	A	B	C	D	E	F	G	H	I	J	K	L	M
2		6		5		4		3		2		1	
3													
4		7		8		9		10		11		12	
5													
6		18		17		16		15		14		13	
7													
8		19		20		21		22		23		24	
9													
10		30		29		28		27		26		25	
11													
12		31		32		33		34		35		36	
13													

A. Description of original monument and accessories and/or subsequent restoration:

1843 GLO James Mullett Set wood posts
12" W. Ash N24°E 41LKS
12" Aspen S48°W 15LKS
1996 James H. Granger #16041
Iron in Mon Box

B. Description of corner evidence found and/or method applied in restoring or reestablishing corner:

FD 1" solid rod in Mon Box.
Accept position as previously established
Unable to remove rod. Road Commission welded 5/8" rebar on end of solid rod.


ACCEPTED BY THE IOSCO COUNTY
SURVEY PEER GROUP AS THE
OFFICIAL CORNER UNDER P.A.
315 OF 1990 AT A MEETING
HELD ON 9-16-97

James H. Granger

C. Description of monument for corner and accessories established to perpetuate locating the position of the corner:

Welded 5/8" Rebar on 1" solid rod with Remon Cap in Mon. Box

6" Ash	N19°W	53.34'	nail & tag 16041
Utility Pole	N40°E	36.76'	nail & tag 16041
5" W. Birch	S53°E	62.04'	nail & tag 16041
5" Ash	S45°W	77.19'	nail & tag 16041

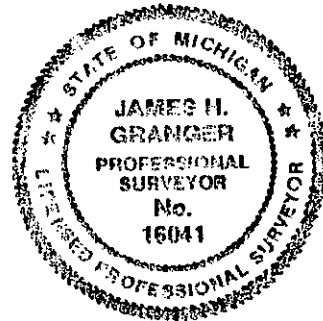

Signed by James H. Granger
Surveyor's Michigan License No. 16041

Date Nov. 10, 1997

**SURVEY &
REMONUMENTATION**

MAR 18 1998

SECTION