

**REMONUMENTATION CORNER
LAND CORNER RECORDATION CERTIFICATE
Filing Requirement of Act 74, Mich. P.A. 1970**

STATE OF MICHIGAN
IOSCO COUNTY
FILED

For corners in

<u>Iosco</u> (County)	Located In:	Corner Code #
1. Public Land Survey	T21N R7E	H-7
	T___ R___	_____
	T___ R___	_____
	T___ R___	_____
2. Property Controlling in Section	S___ T___ R___	_____
	S___ T___ R___	_____
3. Miscellaneous Property in Sec.	S___ T___ R___	_____
	S___ T___ R___	_____

3 DEC 97 11:52 A.M.

RONITA M. COYLE
REGISTER OF DEEDS

97-65

Register of Deeds Stamp & File Number

4. Lot No. _____, Recorded Plat _____
5. Private Claims _____

I, James H. Granger, in a field survey on August 12, 1997 do hereby state that under requirements of P.A. 74, Michigan P.A. of 1970, the corner points mentioned in lines 1 and 2 above were in conformance with regulations and rules therefore as required in the current manual of survey instructions of the United States Department of the Interior, Bureau of Land Management or by a decree of a Court of Law and/or that the corner points mentioned in lines 3, 4 and 5 above were in conformance with the rules of the Michigan Board of Land Surveyors or by a Decree of a Court of Law; established, re-established, monumented, recovered, found as expressed below:

1	A	B	C	D	E	F	G	H	I	J	K	L	M
2		6		5		4		3		2		1	
3													
4		7		8		9		10		11		12	
5													
6		18		17		16		15		14		13	
7													
8		19		20		21		22		23		24	
9													
10		30		29		28		27		26		25	
11													
12		31		32		33		34		35		36	
13													

NOTE: Not more than 2 corners, all in the same town and range, may be recorded on this certificate.

A. Description of original monument and accessories and/or subsequent restoration:

- 1843 GLO James Mullett Set wood posts
(need witnesses)
- 1996 James H. Granger #16041
Iron in mon. box.

B. Description of corner evidence found and/or method applied in restoring or reestablishing corner:

FD 1" solid bolt in Mon Box.
Accept position as previously established
Unable to remove solid bolt. Road Commission welded 5/8" rebar on end of bolt.


ACCEPTED BY THE IOSCO COUNTY
SURVEY PEER GROUP AS THE
OFFICIAL CORNER UNDER P.A.
345 OF 1990 AT A MEETING
HELD ON 9-16-97

James H. Granger

C. Description of monument for corner and accessories established to perpetuate locating the position of the corner:

Welded 5/8" Rebar on solid bolt with Remon Cap in Mon. Box

Utility Pole	N30°W	42.68'	nail & tag 16041
3" Ash	N20°E	60.30'	nail & tag 16041
Utility Pole	S30°E	43.17'	nail & tag 16041
Road Sign Post	S45°W	45.67'	nail & tag 16041

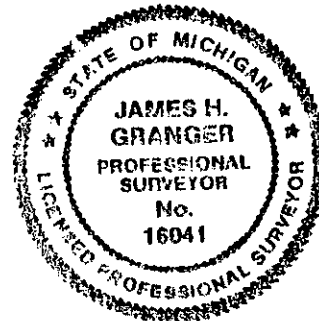

Signed by James H. Granger
Surveyor's Michigan License No. 16041

Date Nov. 10, 1997

FORM APPROVED BY MICHIGAN STATE BOARD OF PROFESSIONAL SURVEYORS, JAN. 28, 1971
REVISED MAY 14, 1975

REVISED JAN., 1983
REVISED OCT., 1995

**SURVEY &
REMONUMENTATION**

MAR 18 1998

SECTION