

**REMONUMENTATION CORNER  
LAND CORNER RECORDATION CERTIFICATE  
Filing Requirement of Act 74, Mich. P.A. 1970**

**97-56**

For corners in

<u>Iosco</u> (County)	Located In:	Corner Code #
1. Public Land Survey	T21N R7E	I-1
	T___ R___	_____
	T___ R___	_____
	T___ R___	_____
2. Property Controlling in Section	S___ T___ R___	_____
	S___ T___ R___	_____
3. Miscellaneous Property in Sec.	S___ T___ R___	_____
	S___ T___ R___	_____

STATE OF MICHIGAN  
IOSCO COUNTY  
FILED

3 DEC 97 11:50 A.M.

RONITA M. COYLE  
REGISTER OF DEEDS

Register of Deeds Stamp & File Number

4. Lot No. \_\_\_\_\_, Recorded Plat \_\_\_\_\_  
5. Private Claims \_\_\_\_\_

I, James H. Granger, in a field survey on August 4, 1997, do hereby state that under requirements of P.A. 74, Michigan P.A. of 1970, the corner points mentioned in lines 1 and 2 above were in conformance with regulations and rules therefore as required in the current manual of survey instructions of the United States Department of the Interior, Bureau of Land Management or by a decree of a Court of Law and/or that the corner points mentioned in lines 3, 4 and 5 above were in conformance with the rules of the Michigan Board of Land Surveyors or by a Decree of a Court of Law; established, re-established, monumented, recovered, found as expressed below:

**NOTE: Not more than 2 corners, all in the same town and range, may be recorded on this certificate.**

1	A	B	C	D	E	F	G	H	I	J	K	L	M
2		6		5		4		3		2		1	
3													
4		7		8		9		10		11		12	
5													
6		18		17		16		15		14		13	
7													
8		19		20		21		22		23		24	
9													
10		30		29		28		27		26		25	
11													
12		31		32		33		34		35		36	
13													

A. Description of original monument and accessories and/or subsequent restoration:

1843 GLO James Mullett Set Wood Post 10" Maple S31°W 73LKS  
12" Maple S19°W 34LKS  
15 LKS W. of SE Cor Sec. 34, T22N, R7E

1973 James Campbell #15397 1" pipe

B. Description of corner evidence found and/or method applied in restoring or reestablishing corner:

Found 1" pipe by Campbell with 3/8" rod inside misidentified as SE Cor Sec. 34, T22N, R7E.  
Nothing found at GLO distance West of SE Cor of Sec. 34  
Establish position 9.90 ft West of SE Cor of Sec. 34 on line between SE and S 1/4 Remon Corners of Said Sec. 34.


ACCEPTED BY THE IOSCO COUNTY  
SURVEY PEER GROUP AS THE  
OFFICIAL CORNER UNDER P.A.  
345 OF 1990 AT A MEETING  
HELD ON 9-16-97

*James H. Granger*

C. Description of monument for corner and accessories established to perpetuate locating the position of the corner:

Set 5/8" rebar with Remon Cap in Mon Box.

8" Box Elder	N25°E	92.48'	fd 60 D spike w/ribbon
Utility Pole	S54°E	52.33'	nail & tag 16041
10" Elm	S 3°W	63.19'	fd 60 D spike w/ribbon
magnetic PK, N. end 24" steel culv.	N46°W	53.30'	
I-13 Remon Cap in Mon Box East		9.90'	(T22N, R7E)

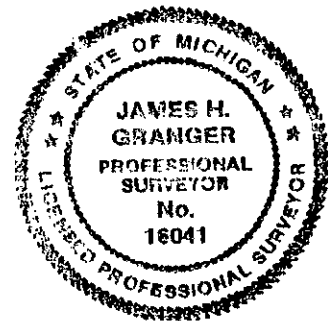

Signed by James H. Granger  
Surveyor's Michigan License No. 16041

Date November 10, 1997

FORM APPROVED BY MICHIGAN STATE BOARD OF PROFESSIONAL SURVEYORS, JAN. 28, 1971  
REVISED MAY 14, 1975

REVISED JAN, 1983  
REVISED OCT, 1995

**SURVEY &  
REMONUMENTATION**

MAR 18 1998

SECTION