

**REMONUMENTATION CORNER  
LAND CORNER RECORDATION CERTIFICATE  
Filing Requirement of Act 74, Mich. P.A. 1970**

For corners in

<u>Iosco</u> (County)	Located In:	Corner Code #
1. Public Land Survey	<u>T21N R7E</u>	<u>J-1</u>
	T <u>    </u> R <u>    </u>	<u>          </u>
	T <u>    </u> R <u>    </u>	<u>          </u>
	T <u>    </u> R <u>    </u>	<u>          </u>
2. Property Controlling in Section	S <u>    </u> T <u>    </u> R <u>    </u>	<u>          </u>
	S <u>    </u> T <u>    </u> R <u>    </u>	<u>          </u>
3. Miscellaneous Property in Sec.	S <u>    </u> T <u>    </u> R <u>    </u>	<u>          </u>
	S <u>    </u> T <u>    </u> R <u>    </u>	<u>          </u>

STATE OF MICHIGAN  
IOSCO COUNTY  
FILED

3 DEC 97 11:51 A.M.

RONITA M. COYLE  
REGISTER OF DEEDS

**97-58**

Register of Deeds Stamp & File Number

4. Lot No. \_\_\_\_\_, Recorded Plat \_\_\_\_\_  
5. Private Claims \_\_\_\_\_

I, James H. Granger, in a field survey on August 4, 1997 do hereby state that under requirements of P.A. 74, Michigan P.A. of 1970, the corner points mentioned in lines 1 and 2 above were in conformance with regulations and rules therefore as required in the current manual of survey instructions of the United States Department of the Interior, Bureau of Land Management or by a decree of a Court of Law and /or that the corner points mentioned in lines 3, 4 and 5 above were in conformance with the rules of the Michigan Board of Land Surveyors or by a Decree of a Court of Law, established, re-established, monumented, recovered, found as expressed below:

**NOTE: Not more than 2 corners, all in the same town and range, may be recorded on this certificate.**

1	A	B	C	D	E	F	G	H	I	J	K	L	M
2		6		5		4		3		2		1	
3													
4		7		8		9		10		11		12	
5													
6		18		17		16		15		14		13	
7													
8		19		20		21		22		23		24	
9													
10		30		29		28		27		26		25	
11													
12		31		32		33		34		35		36	
13													

A. Description of original monument and accessories and/or subsequent restoration:

NO ORIGINAL GLO NOTES

B. Description of corner evidence found and/or method applied in restoring or reestablishing corner:

Nothing found. Established position by single proportionate measurement on line between SE and S 1/4 Remon Corners of Sec 35, T22N, R7E.

ACCEPTED BY THE IOSCO COUNTY  
SURVEY PEER GROUP AS THE  
OFFICIAL CORNER UNDER P.A.  
345 OF 1990 AT A MEETING  
HELD ON 9-16-97


*James H. Granger*

C. Description of monument for corner and accessories established to perpetuate locating the position of the corner:

Set 5/8" Rebar with Remon Cap in Mon. Box

4" W. Pine	N 63°E	90.95'	nail & tag 16041
5" Cedar Post	S 4°W	38.52'	nail & tag 16041
8" Cottonwood	S 73°W	89.93'	nail & tag 16041
Utility Pole	N 35°W	95.66'	nail & tag 16041

J-13 Remon Cap in Mon. Box East 5.64' (T22N, R7E)

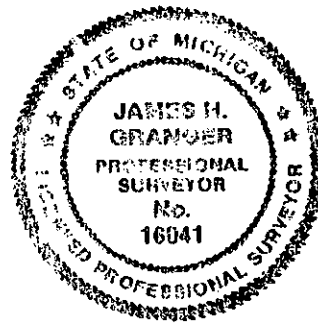

Signed by *James H. Granger*  
Surveyor's Michigan License No. 16041

Date Nov. 10, 1997

**SURVEY &  
REMONUMENTATION**

MAR 18 1998

SECTION