

**REMONUMENTATION CORNER  
LAND CORNER RECORDATION CERTIFICATE  
Filing Requirement of Act 74, Mich. P.A. 1970**

STATE OF MICHIGAN  
IOSCO COUNTY  
FILED

For corners in

<u>Iosco</u> (County)	Located In:	Corner Code #
1. Public Land Survey	T22N R7E T21N R7E T___ R___ T___ R___	K-13 <u>K-1</u> _____ _____
2. Property Controlling in Section	S___ T___ R___ S___ T___ R___	_____ _____
3. Miscellaneous Property in Sec.	S___ T___ R___ S___ T___ R___	_____ _____

3 DEC 97 11:51 A.M.

RONITA M. COYLE  
REGISTER OF DEEDS

**97-60**

Register of Deeds Stamp & File Number

4. Lot No. \_\_\_\_\_, Recorded Plat \_\_\_\_\_  
5. Private Claims \_\_\_\_\_

I, James H. Granger, in a field survey on August 4, 1997 do hereby state that under requirements of P.A. 74, Michigan P.A. of 1970, the corner points mentioned in lines 1 and 2 above were in conformance with regulations and rules therefore as required in the current manual of survey instructions of the United States Department of the Interior, Bureau of Land Management or by a decree of a Court of Law and/or that the corner points mentioned in lines 3, 4 and 5 above were in conformance with the rules of the Michigan Board of Land Surveyors or by a Decree of a Court of Law, established, re-established, monumented, recovered, found as expressed below:

**NOTE: Not more than 2 corners, all in the same town and range, may be recorded on this certificate.**

1	A	B	C	D	E	F	G	H	I	J	K	L	M
2		6		5		4		3		2		1	
3													
4		7		8		9		10		11		12	
5													
6		18		17		16		15		14		13	
7													
8		19		20		21		22		23		24	
9													
10		30		29		28		27		26		25	
11													
12		31		32		33		34		35		36	
13													

**A. Description of original monument and accessories and/or subsequent restoration:**

1838	GLO	James Mullett	Set wood post	witnesses 20" W. Pine N73°W 41LKS 18" W. Pine N44°E 23LKS
1945		R. J. Cooke #2335		Subdivision "Elms"
1946		R. J. Cooke #2335		Subdivision "1st Add to the Elms"
1947		R. J. Cooke #2335		"Tawas Heights" Sub'd
1950		R. J. Cooke #2335		"2nd Add to the Elms" Sub'd
1958		Carl Small		"Ray M. Clark" Sub'd
1959		James Scott		"1st Add to Ray M. Clark" Sub'd
1973		Richard Miller #16050		Survey
1974		Richard Miller #16050		Survey
1974		Richard Miller #16050		Survey
1983		Richard Miller #16050		LCRC
1996		Richard Miller #16050		Amended Plat on Ray M. Clark Sub'd

ACCEPTED BY THE IOSCO COUNTY  
SURVEY PEER GROUP AS THE  
OFFICIAL CORNER UNDER P.A.  
345 OF 1990 AT A MEETING  
HELD ON 9-16-97

*James H. Granger*


**B. Description of corner evidence found and/or method applied in restoring or reestablishing corner:**

Found P.K. Nail. Position agrees acceptably with subdivisions of record.  
Accepted position as previously established.

**C. Description of monument for corner and accessories established to perpetuate locating the position of the corner:**

Set 5/8" Rebar with Remon Cap in Mon Box

Con. Mon.	North	32.94'	
	N54°E	63.75'	fd 60 D Spike w/ribbon
Utility Pole	S 4°W	68.59'	nail & tag 16041
NW cor. Block Garage	S60°W	73.90'	
4" Sq. Fence Post	N 7°W	37.06'	nail & tag 16041

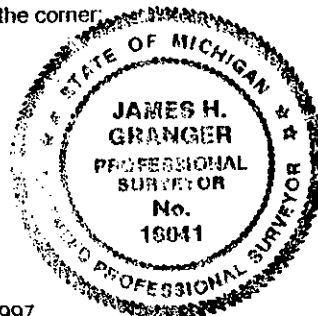

Signed by James H. Granger  
Surveyor's Michigan License No. 16041

Date Nov. 10, 1997

FORM APPROVED BY MICHIGAN STATE BOARD OF PROFESSIONAL SURVEYORS, JAN. 28, 1971  
REVISED MAY 14, 1975

REVISED JAN. 1983  
REVISED OCT. 1995

**SURVEY &  
REMONUMENTATION**

**MAR 18 1998**

**SECTION**