

LAND CORNER RECORDATION CERTIFICATE

FILING REQUIREMENT OF ACT 74, MICH. P.A.1970

FOR CORNERS OF--	LOCATED IN--	CORNER CODE NUMBER
1. PUBLIC LAND SURVEY _____	T. <u>21</u> N. <u>XX</u> R. <u>7</u> E. <u>XX</u>	F-13, G-13
2. PROPERTY CONTROLLING IN SECTION _____	T. _____ N. _____ R. _____ E. _____ W. _____	_____
3. MISCELLANEOUS PROPERTY IN SECTION _____	T. _____ N. _____ R. _____ E. _____ W. _____	_____
4. LOT NO. _____, RECORDED PLAT _____		
5. PRIVATE CLAIMS _____		

REGISTER OF DEEDS STAMP AND FILING NUMBER

I, Kenneth J. Ostling do hereby certify that under requirements of P.A. 74, Michigan P.A. of 1970, the corner points mentioned in lines 1 and 2 above (identified with circles on index code diagram—over) were, in a field survey on 5-14 1973, established, re-established, monumented, re-monumented, recovered or restored as expressed below and in conformance with regulations and rules therefore as required in the current manual of survey instructions of the United States Department of the Interior, Bureau of Land Management or by a decree of a court of law. Furthermore, that the corner points mentioned in lines 3, 4 and 5 above were, in a field survey on _____ 19____, found, recovered, restored, established or re-established as expressed below and in conformance with the rules of the Michigan State Board of Registration for Land Surveyors or, by a Decree of a Court of law:

A. Description of original monument and accessories and/or subsequent restoration:

B. Description of corner evidence found and/or method applied in restoring or re-establishing corner:

F-13 Found squared post and NBT of 1908 survey.

G-13 Corner set relative to W 1/16 and S 1/4 corner of Section 34, which fits good for measurement of 1908 survey record between S 1/4 of 34 and S 1/4 of 33.

C. Description of monument for corner and accessories established to perpetuate locating the position of the corner:

F-13
Set DNR Monument


6" Maple N63W 27.5'
4" Maple N55E 30.1'
*30" W. Pine stump N12W 31.7'
*Old NBT

G-13
Set DNR Monument

11" Bl. Cherry N77E 100.2'
6" Poplar in ditch S70E 41.2'

SIGNED BY Kenneth J. Ostling DATE _____

SURVEYOR'S MICHIGAN REGISTRATION NO. 10068

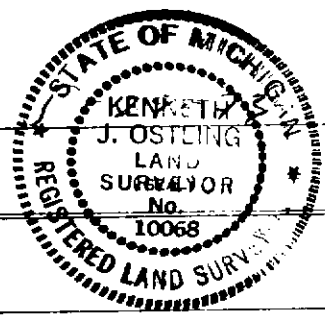

FOR STATE AND UNITED STATES AGENCIES:

SIGNED BY _____ DATE _____
CHIEF OF SURVEY PARTY

APPROVED AND SIGNED BY _____ DATE _____
MICHIGAN REGISTERED LAND SURVEYOR (SEAL)

SURVEYOR'S MICHIGAN REGISTRATION NO. _____