

**SURVEY & REMONUMENTATION**

FEB 16 1999

**REMONUMENTATION CORNER**

**SECTION**

**LAND CORNER RECORDATION CERTIFICATE**  
Filing Requirement of Act 74, Mich. P.A. 1970

STATE OF MICHIGAN  
IOSCO COUNTY  
**98-22**  
FILED

8 DEC 98 1:11 P.M.

RONITA H. COYLE  
REGISTER OF DEEDS

For corners in

|                                    |                           |               |
|------------------------------------|---------------------------|---------------|
| <u>IOSCO</u><br>(County)           | Located In:               | Corner Code # |
| 1. Public Land Survey              | T <u>21</u> N R <u>6E</u> | <u>A-1</u>    |
|                                    | T <u>21</u> N R <u>5E</u> | <u>M-1</u> ✓  |
|                                    | T <u>22</u> N R <u>6E</u> | <u>A-13</u>   |
|                                    | T <u>22</u> N R <u>5E</u> | <u>M-13</u>   |
| 2. Property Controlling in Section | S _____ T _____ R _____   | _____         |
| 3. Miscellaneous Property in Sec.  | S _____ T _____ R _____   | _____         |
|                                    | S _____ T _____ R _____   | _____         |

**Register of Deeds Stamp & File Number**

|    | A | B  | C | D  | E | F  | G | H  | I | J  | K | L  | M |
|----|---|----|---|----|---|----|---|----|---|----|---|----|---|
| 1  |   |    |   |    |   |    |   |    |   |    |   |    |   |
| 2  |   | 6  |   | 5  |   | 4  |   | 3  |   | 2  |   | 1  |   |
| 3  |   |    |   |    |   |    |   |    |   |    |   |    |   |
| 4  |   | 7  |   | 8  |   | 9  |   | 10 |   | 11 |   | 12 |   |
| 5  |   |    |   |    |   |    |   |    |   |    |   |    |   |
| 6  |   | 18 |   | 17 |   | 16 |   | 15 |   | 14 |   | 13 |   |
| 7  |   |    |   |    |   |    |   |    |   |    |   |    |   |
| 8  |   | 19 |   | 20 |   | 21 |   | 22 |   | 23 |   | 24 |   |
| 9  |   |    |   |    |   |    |   |    |   |    |   |    |   |
| 10 |   | 30 |   | 29 |   | 28 |   | 27 |   | 26 |   | 25 |   |
| 11 |   |    |   |    |   |    |   |    |   |    |   |    |   |
| 12 |   | 31 |   | 32 |   | 33 |   | 34 |   | 35 |   | 36 |   |
| 13 |   |    |   |    |   |    |   |    |   |    |   |    |   |

4. Lot No. \_\_\_\_\_, Recorded Plat \_\_\_\_\_  
5. Private Claims \_\_\_\_\_

I, JAMES H. GRANGER, in a field survey on SEPTEMBER 29, 1998, do hereby state that under requirements of P.A. 74, Michigan P.A. of 1970, the corner points mentioned in lines 1 and 2 above were in conformance with regulations and rules therefore as required in the current manual of survey instructions of the United States Department of the Interior, Bureau of Land Management or by a decree of a Court of Law and /or that the corner points mentioned in lines 3, 4 and 5 above were in conformance with the rules of the Michigan Board of Land Surveyors or by a Decree of a Court of Law; established, re-established, monumented, recovered, found as expressed below:

**NOTE: Not more than 2 corners, all in the same town and range, may be recorded on this certificate.**

**A. Description of original monument and accessories and/or subsequent restoration:**

- 1837 GLO Lewis Clason Set Wood Post 12" Hemlock S60°E 15 lks  
12" Hemlock N40°E 28 lks
- 1985 LCRC Tim Lapham #27595 Fd 1 1/2" pipe in clay tile Set 4 witnesses L86, P 6
- 1990 LCRC Philip Case #30079 Set 1/2" rebar by Double Over S 1/4 Set 4 witnesses L90, P 28
- 1997 Survey James H. Granger #16041 Fd., clay tile & Lapham witnesses. No 1 1/2" pipe was found Set 1/2" iron bar w/ cap 16041 per Lapham witnesses.

**B. Description of corner evidence found and/or method applied in restoring or reestablishing corner:**


Confirmed existence of 1/2" rebar set in 1997 and witnesses. Accepted position as perpetuated.

ACCEPTED BY THE IOSCO COUNTY SURVEY PEER GROUP AS THE OFFICIAL CORNER UNDER P.A. 345 OF 1990 AT A MEETING HELD ON 9-22-98

*James H. Granger*

**C. Description of monument for corner and accessories established to perpetuate locating the position of the corner:**

- Set 5/8" x24" iron rod w/ remon cap
- Spruce 10" dia. N10°W 5.73' nail & tag
- Utility Pole S30°E 40.44' nail & tag
- 1/2" iron rod South 38.95' (set by case)
- W. Pine 16" dia. S35°W 64.98' nail & tag

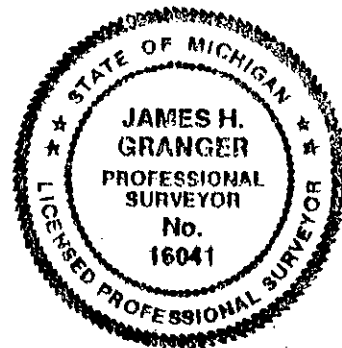

Signed by James H. Granger  
Surveyor's Michigan License No. 16041

Date November 2, 1998