

**SURVEY &
REMONUMENTATION**

FEB 16 1999

REMONUMENTATION CORNER

STATE OF MICHIGAN
IOSCO COUNTY
98-22
FILED
8 DEC 98 1:11 P.M.

SECTION

LAND CORNER RECORDATION CERTIFICATE
Filing Requirement of Act 74, Mich. P.A. 1970

For corners in

<u>IOSCO</u> (County)	Located In:	Corner Code #
1. Public Land Survey	T <u>21N</u> R <u>6E</u>	<u>A-1</u> ✓
	T <u>21N</u> R <u>5E</u>	<u>M-1</u>
	T <u>22N</u> R <u>6E</u>	<u>A-13</u>
	T <u>22N</u> R <u>5E</u>	<u>M-13</u>
2. Property Controlling in Section	S ___ T ___ R ___	___
	S ___ T ___ R ___	___
3. Miscellaneous Property in Sec.	S ___ T ___ R ___	___
	S ___ T ___ R ___	___

BONITA M. COYLE
REGISTER OF DEEDS

Register of Deeds Stamp & File Number

4. Lot No. _____, Recorded Plat _____
5. Private Claims _____

A	B	C	D	E	F	G	H	I	J	K	L	M
1												
2	6		5		4		3		2			1
3												
4	7		8		9		10		11			12
5												
6	18		17		16		15		14			13
7												
8	19		20		21		22		23			24
9												
10	30		29		28		27		26			25
11												
12	31		32		33		34		35			36

I, JAMES H. GRANGER, in a field survey on SEPTEMBER 29, 19 98 do hereby state that under requirements of P.A. 74, Michigan P.A. of 1970, the corner points mentioned in lines 1 and 2 above were in conformance with regulations and rules therefore as required in the current manual of survey instructions of the United States Department of the Interior, Bureau of Land Management or by a decree of a Court of Law and /or that the corner points mentioned in lines 3, 4 and 5 above were in conformance with the rules of the Michigan Board of Land Surveyors or by a Decree of a Court of Law; established, re-established, monumented, recovered, found as expressed below:

NOTE: Not more than 2 corners, all in the same town and range, may be recorded on this certificate.

A. Description of original monument and accessories and/or subsequent restoration:

- 1837 GLO Lewis Clason Set Wood Post 12" Hemlock S60°E 15 lks
12" Hemlock N40°E 28 lks
- 1985 LCRC Tim Lapham #27595 Fd 1 1/2" pipe in clay tile Set 4 witnesses L86, P 6
- 1990 LCRC Philip Case #30079 Set 1/2" rebar by Double Over S 1/4 Set 4 witnesses L90, P 28
- 1997 Survey James H. Granger #16041 Fd. clay tile & Lapham witnesses. No 1 1/2" pipe was found Set 1/2" iron bar w/ cap 16041 per Lapham witnesses.

B. Description of corner evidence found and/or method applied in restoring or reestablishing corner:


Confirmed existence of 1/2" rebar set in 1997 and witnesses. Accepted position as perpetuated.

ACCEPTED BY THE IOSCO COUNTY
SURVEY PEER GROUP AS THE
OFFICIAL CORNER UNDER P.A.
345 OF 1990 AT A MEETING
HELD ON 9-22-98

James H. Granger

C. Description of monument for corner and accessories established to perpetuate locating the position of the corner:

- Set 5/8" x24" iron rod w/ remon cap
- Spruce 10" dia. N10°W 5.73' nail & tag
- Utility Pole S30°E 40.44' nail & tag
- 1/2" iron rod South 38.95' (set by case)
- W. Pine 16" dia. S35°W 64.98' nail & tag

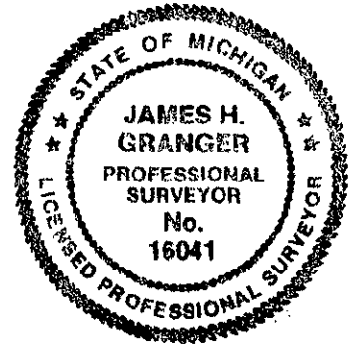

Signed by James H. Granger
Surveyor's Michigan License No. 16041

Date November 2, 1998