

SURVEY & REMONUMENTATION

FEB 16 1999

REMONUMENTATION CORNER

SECTION

LAND CORNER RECORDATION CERTIFICATE
Filing Requirement of Act 74, Mich. P.A. 1970

STATE OF MICHIGAN
IOSCO COUNTY
98-25
FILED
8 DEC 98 1:12 P.M.
RONITA M. COYLE
REGISTER OF DEEDS

For corners in

<u>IOSCO</u> (County)	Located In:	Corner Code #
1. Public Land Survey	T <u>21N</u> R <u>6E</u>	<u>C-1</u>
	T <u> </u> R <u> </u>	<u> </u>
	T <u> </u> R <u> </u>	<u> </u>
	T <u> </u> R <u> </u>	<u> </u>
2. Property Controlling in Section	S <u> </u> T <u> </u> R <u> </u>	<u> </u>
	S <u> </u> T <u> </u> R <u> </u>	<u> </u>
3. Miscellaneous Property in Sec.	S <u> </u> T <u> </u> R <u> </u>	<u> </u>
	S <u> </u> T <u> </u> R <u> </u>	<u> </u>

4. Lot No. _____, Recorded Plat _____
5. Private Claims _____

I, JAMES H. GRANGER, in a field survey on SEPTEMBER 29, 19 98 do hereby state that under requirements of P.A. 74, Michigan P.A. of 1970, the corner points mentioned in lines 1 and 2 above were in conformance with regulations and rules therefore as required in the current manual of survey instructions of the United States Department of the Interior, Bureau of Land Management or by a decree of a Court of Law and /or that the corner points mentioned in lines 3, 4 and 5 above were in conformance with the rules of the Michigan Board of Land Surveyors or by a Decree of a Court of Law; established, re-established, monumented, recovered, found as expressed below:

NOTE: Not more than 2 corners, all in the same town and range, may be recorded on this certificate.

A. Description of original monument and accessories and/or subsequent restoration:

1843 GLO John Mullett Set Wood Post 20" W. Pine S59°E 42 lks
10" Maple S33°W 12 lks
18 lks W. of SW cor. Sec. 32 T22N, R6E

B. Description of corner evidence found and/or method applied in restoring or reestablishing corner:

Field measure from NE cor. Sec. 3 to NW cor. Sec. 6. Establish approx. location based on single proportionate measurement. No original evidence found. Evaluated distance on both sides of Township line with measured vs. recorded distances. Established cor. location on line between NE corner Sec. 3 and NW cor. Sec. 6 at 5,244.60' West on NE cor. Sec. 5, and 5,304.21' East of NW cor. Sec. 6.


C. Description of monument for corner and accessories established to perpetuate locating the position of the corner:

Set 5/8" x24" iron rod w/ remon cap

Aspen 14" dia. N15°E 16.41' nail & tag
Aspen 16" dia. N82°W 23.53' nail & tag
Ash 6" dia. S20°W 7.40' nail & tag
Twin Ash 8" dia. S34°E 11.53' nail & tag

ACCEPTED BY THE IOSCO COUNTY SURVEY PEER GROUP AS THE OFFICIAL CORNER UNDER P.A. 345 OF 1990 AT A MEETING HELD ON 9-22-98

James H. Granger

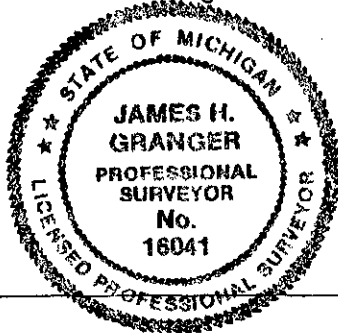

Signed by James H. Granger
Surveyor's Michigan License No. 16041

Date November 2, 1998