

FEB 16 1999

REMONUMENTATION CORNER

SECTION

LAND CORNER RECORDATION CERTIFICATE  
Filing Requirement of Act 74, Mich. P.A. 1970

STATE OF MICHIGAN  
IOSCO COUNTY  
98-26  
FILED  
8 DEC 98 1:12 P.M.  
BONITA M. COYLE  
REGISTER OF DEEDS

For corners in

<u>IOSCO</u> (County)	Located In:	Corner Code #
1. Public Land Survey	T <u>21NR 6E</u>	<u>D-1</u>
	T <u>    </u> R <u>    </u>	<u>    </u>
	T <u>    </u> R <u>    </u>	<u>    </u>
	T <u>    </u> R <u>    </u>	<u>    </u>
2. Property Controlling in Section	S <u>    </u> T <u>    </u> R <u>    </u>	<u>    </u>
	S <u>    </u> T <u>    </u> R <u>    </u>	<u>    </u>
3. Miscellaneous Property in Sec.	S <u>    </u> T <u>    </u> R <u>    </u>	<u>    </u>
	S <u>    </u> T <u>    </u> R <u>    </u>	<u>    </u>
4. Lot No. <u>    </u> , Recorded Plat <u>    </u>		
5. Private Claims <u>    </u>		

Register of Deeds Stamp & File Number

A	B	C	D	E	F	G	H	I	J	K	L	M
	6		5		4		3		2		1	
	7		8		9		10		11		12	
	18		17		16		15		14		13	
	19		20		21		22		23		24	
	30		29		28		27		26		25	
	31		32		33		34		35		36	

I, JAMES H. GRANGER, in a field survey on SEPTEMBER 29, 19 98, do hereby state that under requirements of P.A. 74, Michigan P.A. of 1970, the corner points mentioned in lines 1 and 2 above were in conformance with regulations and rules therefore as required in the current manual of survey instructions of the United States Department of the Interior, Bureau of Land Management or by a decree of a Court of Law and /or that the corner points mentioned in lines 3, 4 and 5 above were in conformance with the rules of the Michigan Board of Land Surveyors or by a Decree of a Court of Law; established, re-established, monumented, recovered, found as expressed below:

NOTE: Not more than 2 corners, all in the same town and range, may be recorded on this certificate.

A. Description of original monument and accessories and/or subsequent restoration:

No original corner set

ACCEPTED BY THE IOSCO COUNTY SURVEY PEER GROUP AS THE OFFICIAL CORNER UNDER P.A. 345 OF 1990 AT A MEETING HELD ON 9-22-98

*James H. Granger*


B. Description of corner evidence found and/or method applied in restoring or reestablishing corner:

Field measure from NE cor. Sec. 3 to NW cor. Sec. 6. Establish prorated position for NW cor. Sec. 5. Establish cor. location midway and online between NE & NW sec. corners at 2,622.30' West of NE Sec. corner

C. Description of monument for corner and accessories established to perpetuate locating the position of the corner:

Set 5/8" x24" iron rod w/ remon cap

W Birch 12" dia. (clump)	N6°E	32.20'	nail & tag
Twin Maple 20" dia.	S64°E	20.91'	nail & tag
Maple 8" dia.	South	10.74'	nail & tag
Triple Maple 14" dia.	S88°W	6.95'	nail & tag

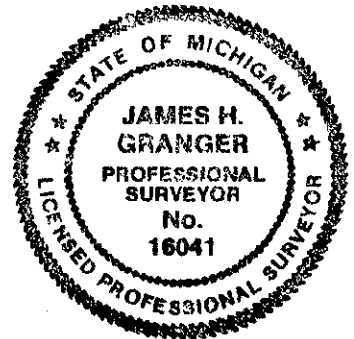

Signed by James H. Granger  
Surveyor's Michigan License No. 16041

Date November 2, 1998