

FEB 16 1999

REMONUMENTATION CORNER

SECTION

LAND CORNER RECORDATION CERTIFICATE
Filing Requirement of Act 74, Mich. P.A. 1970

STATE OF MICHIGAN
IOSCO COUNTY
FILED
98-27
DEC 98 1:12 P.M.

BONITA M. COYLE
REGISTER OF DEEDS

For corners in

<u>IOSCO</u> (County)	Located In:	Corner Code #
1. Public Land Survey	T <u>21NR 6E</u>	<u>E-1</u>
	T <u> </u> R <u> </u>	<u> </u>
	T <u> </u> R <u> </u>	<u> </u>
	T <u> </u> R <u> </u>	<u> </u>
2. Property Controlling in Section	S <u> </u> T <u> </u> R <u> </u>	<u> </u>
	S <u> </u> T <u> </u> R <u> </u>	<u> </u>
3. Miscellaneous Property in Sec.	S <u> </u> T <u> </u> R <u> </u>	<u> </u>
	S <u> </u> T <u> </u> R <u> </u>	<u> </u>

Register of Deeds Stamp & File Number

4. Lot No. _____, Recorded Plat _____
5. Private Claims _____

A	B	C	D	E	F	G	H	I	J	K	L	M
1												
2	6		5		4		3		2		1	
3												
4	7		8		9		10		11		12	
5												
6	18		17		16		15		14		13	
7												
8	19		20		21		22		23		24	
9												
10	30		29		28		27		26		25	
11												
12	31		32		33		34		35		36	
13												

I, JAMES H. GRANGER, in a field survey on SEPTEMBER 29, 19 98 do hereby state that under requirements of P.A. 74, Michigan P.A. of 1970, the corner points mentioned in lines 1 and 2 above were in conformance with regulations and rules therefore as required in the current manual of survey instructions of the United States Department of the Interior, Bureau of Land Management or by a decree of a Court of Law and /or that the corner points mentioned in lines 3, 4 and 5 above were in conformance with the rules of the Michigan Board of Land Surveyors or by a Decree of a Court of Law; established, re-established, monumented, recovered, found as expressed below:

NOTE: Not more than 2 corners, all in the same town and range, may be recorded on this certificate.

A. Description of original monument and accessories and/or subsequent restoration:

1843 GLO John Mullett Set Wood Post 6" Cedar S55°W 13 lks
7" Hemlock S57°E 23 lks

ACCEPTED BY THE IOSCO COUNTY
SURVEY PEER GROUP AS THE
OFFICIAL CORNER UNDER P.A.
345 OF 1990 AT A MEETING
HELD ON 9-22-98

James H. Granger


B. Description of corner evidence found and/or method applied in restoring or reestablishing corner:

Field measure to approx. location based on single proportionate measurement between NE cor. Sec. 3 and NW cor. Sec. 6. No original evidence found. Evaluated measurements on both sides of Township line with measured vs. recorded distance. Establish cor. location on line between NE corner Sec. 3 and NW cor. Sec. 6 at 5,212.38' West of NE cor. of Sec. 3.

C. Description of monument for corner and accessories established to perpetuate locating the position of the corner:

Set 5/8" x24" iron rod w/ remon cap

Maple 8" dia.	N81°E	30.31'	nail & tag
W. Pine 18" dia.	S47°E	39.70'	nail & tag
Aspen 8" dia.	S49°W	52.07'	nail & tag
Twin W. Birch 8" dia.	N61°W	37.76'	nail & tag

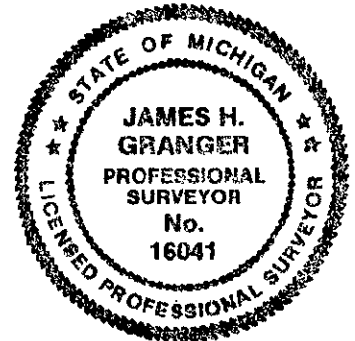

Signed by James H. Granger
Surveyor's Michigan License No. 16041

Date November 2, 1998