

**IOSCO COUNTY REMONUMENTATION  
LAND CORNER RECORDATION CERTIFICATE  
Filing Requirement of Act 74, Mich. P.A. 1970**

For corners in

041 2000


Iosco Co. \_\_\_\_\_ Located In: \_\_\_\_\_ Corner Code # \_\_\_\_\_  
(County)

1. Public Land Survey T 21NR 6E E-9  
T \_\_\_\_\_ R \_\_\_\_\_  
T \_\_\_\_\_ R \_\_\_\_\_  
T \_\_\_\_\_ R \_\_\_\_\_  
T \_\_\_\_\_ R \_\_\_\_\_  
2. Property Controlling S \_\_\_\_\_ T \_\_\_\_\_ R \_\_\_\_\_  
in Section S \_\_\_\_\_ T \_\_\_\_\_ R \_\_\_\_\_  
3. Miscellaneous S \_\_\_\_\_ T \_\_\_\_\_ R \_\_\_\_\_  
Property in Sec. S \_\_\_\_\_ T \_\_\_\_\_ R \_\_\_\_\_

**SURVEY &  
REMONUMENTATION**

**FEB 15 2001**

**SECTION \_\_\_\_\_**

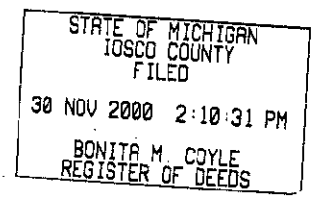

Register of Deeds Stamp & File Number

4. Lot No. \_\_\_\_\_, Recorded Plat \_\_\_\_\_  
5. Private Claims \_\_\_\_\_

	A	B	C	D	E	F	G	H	I	J	K	L	M
1													
2		6		5		4		3		2		1	
3													
4		7		8		9		10		11		12	
5													
6	18		17		16		15		14		13		
7													
8	19		20		21		22		23		24		
9													
10	30		29		28		27		26		25		
11													
12	31		32		33		34		35		36		
13													

I, JAMES H. GRANGER, in a field survey on July, 2000 do hereby state that under requirements of P.A. 74, Michigan P.A. of 1970, the corner points mentioned in lines 1 and 2 above were in conformance with regulations and rules therefore as required in the current manual of survey instructions of the United States Department of the Interior, Bureau of Land Management or by a decree of a Court of Law and /or that the corner points mentioned in lines 3, 4 and 5 above were in conformance with the rules of the Michigan Board of Land Surveyors or by a Decree of a Court of Law; established, re-established, monumented, recovered, found as expressed below:

**NOTE: Not more than 4 corners, all in the same town and range, may be recorded on this certificate.**

A. Description of original monument and accessories and/or subsequent restoration:

- 1843 GLO Set Wood Post  
John Mullett 10" Maple S57°W 11 lks  
J.H. Munro 8" Hemlock N29°E 24 lks
- 1977 Richard Miller 16050
- 1995 James H. Granger 16041


ACCEPTED BY THE IOSCO COUNTY SURVEY PEER GROUP AS THE OFFICIAL CORNER UNDER P.A. 345 OF 1990 AT A MEETING HELD ON OCT 11, 2000  
*James H. Granger*

B. Description of corner evidence found and/or method applied in restoring or reestablishing corner:

During survey of S1/2 of NW1/4 of Sec. 29, found boat spike in mon. box in intersection of Turtle Rd. and National City Rd. Measurements to S & W agreed reasonably well with GLO measurements.

C. Description of monument for corner and accessories established to perpetuate locating the position of the corner:

- 5/8" x 30" rebar w/Remon Cap in mon. box
- Fence post with spike N48°E 64.70'
- 7" Poplar S71°E 95.38' nail & tag 16041
- PP with spike S48°W 79.46'
- corner fence post N18°W 90.22' nail & tag 16041

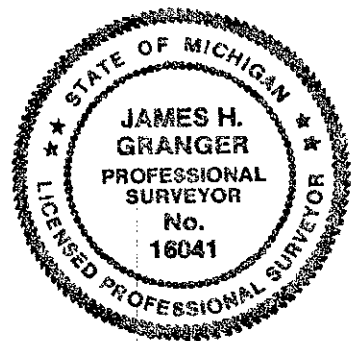

Signed by *James H. Granger*  
Surveyor's Michigan License No. 16041

Date NOV. 29, 2000