

**IOSCO COUNTY REMONUMENTATION
LAND CORNER RECORDATION CERTIFICATE
Filing Requirement of Act 74, Mich. P.A. 1970**

For corners in

Iosco Co.
(County)

Located In:

Corner Code #


044 2000

- 1. Public Land Survey T 21NR 6E
- T ___ R ___
- T ___ R ___
- T ___ R ___
- 2. Property Controlling S ___ T ___ R ___
- in Section S ___ T ___ R ___
- 3. Miscellaneous S ___ T ___ R ___
- Property in Sec. S ___ T ___ R ___

**G-9 SURVEY &
REMONUMENTATION**

FEB 15 2001

SECTION

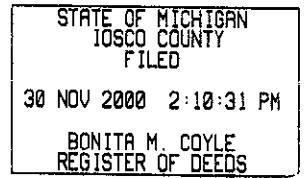

Register of Deeds Stamp & File Num

4. Lot No. _____, Recorded Plat _____

5. Private Claims _____

	A	B	C	D	E	F	G	H	I	J	K	L
1												
2	6			5		4		3		2		1
3												
4	7			8		9		10		11		1
5												
6	18			17		16		15		14		1
7												
8	19			20		21		22		23		2
9												
10	30			29		28		27		26		2
11												
12	31			32		33		34		35		3
13												

I, JAMES H. GRANGER, in a field survey on July, 2000 do hereby state that under requirements of P.A. 74, Michigan P.A. of 1970, the corner points mentioned in lines 1 and 2 above were in conformance with regulations and rules therefore as required in the current manual of survey instructions of the United States Department of the Interior, Bureau of Land Management or by a decree of a Court of Law and /or that the corner points mentioned in lines 3, 4 and 5 above were in conformance with the rules of the Michigan Board of Land Surveyors or by a Decree of a Court of Law; established, re-established, monumented, recovered, found as expressed below:

NOTE: Not more than 4 corners, all in the same town and range, may be recorded on this certificate.

A. Description of original monument and accessories and/or subsequent restoration:

- 1843 GLO Set wood post
- John Mullett 14" B. Ash S 38°E 7 lks
- J.H. Munro 10" B. Ash N 39°W 32 lks

ACCEPTED BY THE IOSCO COUNTY
SURVEY PEER GROUP AS THE
OFFICIAL CORNER UNDER P.A.
345 OF 1990 AT A MEETING
HELD ON OCT 11, 2000


James H. Granger

B. Description of corner evidence found and/or method applied in restoring or reestablishing corner:

Found existing RR spike in approximate corner location. Verified location against previous survey and against recent work in section by another surveyor.

C. Description of monument for corner and accessories established to perpetuate locating the position of the corner:

- 5/8" x 30" rebar w/Remon Cap.
- 4 x 4 post N65°E 71.66' nail & tag 16041
- 4" Aspen N15°W 50.49' nail & tag 16041
- Fence post S05°W 37.23' nail & tag 16041
- 50" Willow S72°E 117.78' nail & tag 16041

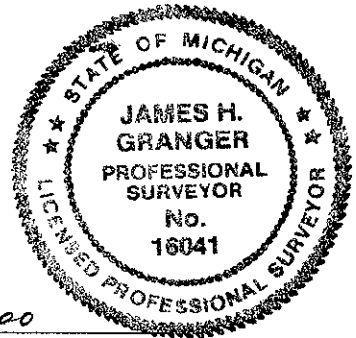

Signed by James H. Granger
Surveyor's Michigan License No. 16041

Date Nov. 29, 2000