


**IOSCO COUNTY REMONUMENTATION
LAND CORNER RECORDATION CERTIFICATE
Filing Requirement of Act 74, Mich. P.A. 1970**

For corners in

043 2000

Iosco Co. Located In: Corner Code #
(County)

1. Public Land Survey T 21NR 6E H-7 **SURVEY &
REMONUMENTATION**
T ___ R ___
T ___ R ___
T ___ R ___
2. Property Controlling S ___ T ___ R ___ **FEB 15 2001**
in Section S ___ T ___ R ___
3. Miscellaneous S ___ T ___ R ___
Property in Sec. S ___ T ___ R ___ **SECTION**

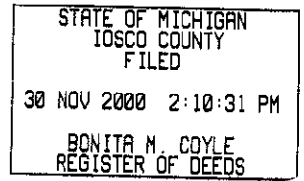

4. Lot No. _____, Recorded Plat _____

5. Private Claims _____

Register of Deeds Stamp & File Number

	A	B	C	D	E	F	G	H	I	J	K	L
1												
2	6		5		4		3		2		1	
3												
4	7		8		9		10		11		12	
5												
6	18		17		16		15		14		13	
7												
8	19		20		21		22		23		24	
9												
10	30		29		28		27		26		25	
11												
12	31		32		33		34		35		36	
13												

I, JAMES H. GRANGER, in a field survey on July, 2000 do hereby state that under requirements of P.A. 74, Michigan P.A. of 1970, the corner points mentioned in lines 1 and 2 above were in conformance with regulations and rules therefore as required in the current manual of survey instructions of the United States Department of the Interior, Bureau of Land Management or by a decree of a Court of Law and for that the corner points mentioned in lines 3, 4 and 5 above were in conformance with the rules of the Michigan Board of Land Surveyors or by a Decree of a Court of Law; established, re-established, monumented, recovered, found as expressed below:

NOTE: Not more than 4 corners, all in the same town and range, may be recorded on this certificate.

A. Description of original monument and accessories and/or subsequent restoration:

1843 GLO Set quarter section post
John Mullett 9" Beech S80°E 25 lks
J.H. Munro 6" B. Ash S63°W 11 lks
1992 James H. Granger 16041
1998 Bill Woods 25882

ACCEPTED BY THE IOSCO COUNTY SURVEY PEER GROUP AS THE OFFICIAL CORNER UNDER P.A. 345 OF 1990 AT A MEETING HELD ON OCT. 11, 2000


James H. Granger

B. Description of corner evidence found and/or method applied in restoring or reestablishing corner:

Found existing corner of record 1/2 inch iron cap 31611 in mon. box.

C. Description of monument for corner and accessories established to perpetuate locating the position of the corner:

5/8" x 30" rebar w/Remon Cap. in mon. box
NE Cor Alabaster Twp Hall S45°W 110.58'
PP N17°W 27.41' nail & tag 16041
Fence Post S60°E 64.75' nail & tag 16041
8" Aspen S53°W 74.92' nail & tag 16041

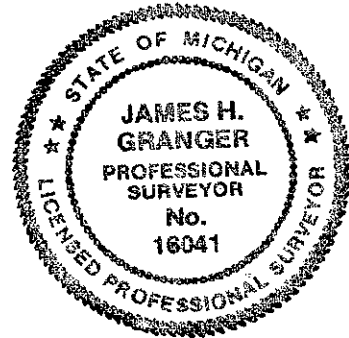

Signed by James H. Granger
Surveyor's Michigan License No. 16041

Date NOV. 29, 2000