

**IOSCO COUNTY REMONUMENTATION
LAND CORNER RECORDATION CERTIFICATE
Filing Requirement of Act 74, Mich. P.A. 1970**

For corners in

Iosco Co. _____ Located In: _____ Corner Code # _____
(County)


045 2000

1. Public Land Survey T 21NR 6E
T _____ R _____
T _____ R _____
T _____ R _____
2. Property Controlling S _____ T _____ R _____
in Section S _____ T _____ R _____
3. Miscellaneous S _____ T _____ R _____
Property in Sec. S _____ T _____ R _____

**SURVEY &
REMONUMENTATION**

FEB 15 2001

SECTION

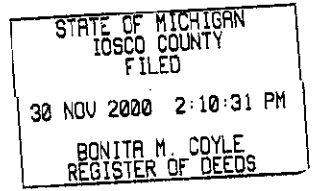

Register of Deeds Stamp & File Number

4. Lot No. _____, Recorded Plat _____
5. Private Claims _____

	A	B	C	D	E	F	G	H	I	J	K	L	M
1													
2		6		5		4		3		2		1	
3													
4		7		8		9		10		11		12	
5													
6		18		17		16		15		14		13	
7													
8		19		20		21		22		23		24	
9													
10		30		29		28		27		26		25	
11													
12		31		32		33		34		35		36	
13													

I, JAMES H. GRANGER, in a field survey on July, 2000 do hereby state that under requirements of P.A. 74, Michigan P.A. of 1970, the corner points mentioned in lines 1 and 2 above were in conformance with regulations and rules therefore as required in the current manual of survey instructions of the United States Department of the Interior, Bureau of Land Management or by a decree of a Court of Law and /or that the corner points mentioned in lines 3, 4 and 5 above were in conformance with the rules of the Michigan Board of Land Surveyors or by a Decree of a Court of Law; established, re-established, monumented, recovered, found as expressed below:

NOTE: Not more than 4 corners, all in the same town and range, may be recorded on this certificate.

A. Description of original monument and accessories and/or subsequent restoration:

S 1/4
1843 GLO Set quarter section post
John Mullett 26" Maple N50°E 17 lks
J.H. Munro 12" Maple S17°W 26 lks
1975 James G. Campbell 15397

ACCEPTED BY THE IOSCO COUNTY
SURVEY PEER GROUP AS THE
OFFICIAL CORNER UNDER P.A.
345 OF 1990 AT A MEETING
HELD ON OCT. 11, 2000

James H. Granger

B. Description of corner evidence found and/or method applied in restoring or reestablishing corner:

No evidence found, corner marker per Campbell Survey. Established by single proportionate distance. Position verified by independent surveyor performing work in Sec. 27.

C. Description of monument for corner and accessories established to perpetuate locating the position of the corner:

5/8" x 30" rebar w/Remon Cap
42" oak N70°E 64.23' nail & tag 16041
PP S32°W 74.26' nail & tag 16041
Fence Post S70°W 107.40' nail & tag 16041
9" W. Pine N31°W 49.09' nail & tag 16041



Signed by James H. Granger
Surveyor's Michigan License No. 16041

Date Nov. 29, 2000