

SURVEY & REMONUMENTATION

FEB 16 1999

REMONUMENTATION CORNER

98-31

SECTION

LAND CORNER RECORDATION CERTIFICATE
Filing Requirement of Act 74, Mich. P.A. 1970

STATE OF MICHIGAN
IOSCO COUNTY
FILED

8 DEC 98 1:13 P.M.

RONITA M. COYLE
REGISTER OF DEEDS

For corners in

<u>IOSCO</u> (County)	Located In:	Corner Code #
1. Public Land Survey	T <u>21NR 6E</u>	<u>I-1</u>
	T <u> </u> R <u> </u>	<u> </u>
	T <u> </u> R <u> </u>	<u> </u>
	T <u> </u> R <u> </u>	<u> </u>
2. Property Controlling in Section	S <u> </u> T <u> </u> R <u> </u>	<u> </u>
	S <u> </u> T <u> </u> R <u> </u>	<u> </u>
3. Miscellaneous Property in Sec.	S <u> </u> T <u> </u> R <u> </u>	<u> </u>
	S <u> </u> T <u> </u> R <u> </u>	<u> </u>

Register of Deeds Stamp & File Number

4. Lot No. _____, Recorded Plat _____
5. Private Claims _____

	A	B	C	D	E	F	G	H	I	J	K	L	M
1													
2		6		5		4		3		2		1	
3													
4		7		8		9		10		11		12	
5													
6		18		17		16		15		14		13	
7													
8		19		20		21		22		23		24	
9													
10		30		29		28		27		26		25	
11													
12		31		32		33		34		35		36	
13													

I, JAMES H. GRANGER, in a field survey on SEPTEMBER 29, 19 98 do hereby state that under requirements of P.A. 74, Michigan P.A. of 1970, the corner points mentioned in lines 1 and 2 above were in conformance with regulations and rules therefore as required in the current manual of survey instructions of the United States Department of the Interior, Bureau of Land Management or by a decree of a Court of Law and /or that the corner points mentioned in lines 3, 4 and 5 above were in conformance with the rules of the Michigan Board of Land Surveyors or by a Decree of a Court of Law, established, re-established, monumented, recovered, found as expressed below:

NOTE: Not more than 2 corners, all in the same town and range, may be recorded on this certificate.

A. Description of original monument and accessories and/or subsequent restoration:

1843 (GLO) John Mullett Set Wood Post 12" elm S40°E 11 lks
12" maple S71°W 71 lks
22 lks W of SW cor, Sec. 35, T22N, R6E

1975 (Survey) James Campbell #15397
Indicates 1/2" pipe no witnesses L248, P261

ACCEPTED BY THE IOSCO COUNTY SURVEY PEER GROUP AS THE OFFICIAL CORNER UNDER P.A. 345 OF 1990 AT A MEETING HELD ON 9-22-98

James H. Granger

B. Description of corner evidence found and/or method applied in restoring or reestablishing corner:


Found ex. 3/4" iron rod in mon. box. Perpetuated by Iosco Co. Road Commission Position is consistent with prorated distances to E and W. Accepted corner location as marked.

C. Description of monument for corner and accessories established to perpetuate locating the position of the corner:

Set remon cap on ex. 5/8" iron rod in mon. box.

Maple 36" dia.	N15°E	125.17'	nail & tag
Maple 8" dia.	N40°E	46.93'	nail & flag
Aspen 16" dia.	S66°W	84.64'	nail & tag
W. Pine 18" dia.	N62°W	101.93'	nail & tag

Remon Cap SE cor Sec. 34 West 14.52' T22N, R6E (I-13)

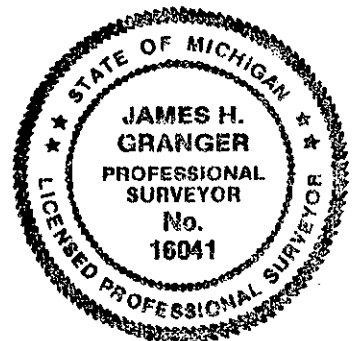

Signed by James H. Granger
Surveyor's Michigan License No. 16041

Date November 2, 1998