

**IOSCO COUNTY REMONUMENTATION
LAND CORNER RECORDATION CERTIFICATE
Filing Requirement of Act 74, Mich. P.A. 1970**

For corners in

<u> Iosco </u> (County)	Located In:	Corner Code #
1. Public Land Survey	<u>T 21NR 6E</u>	<u>I-3</u>
	T <u> </u> R <u> </u>	<u> </u>
	T <u> </u> R <u> </u>	<u> </u>
	T <u> </u> R <u> </u>	<u> </u>
2. Property Controlling in Section	S <u> </u> T <u> </u> R <u> </u>	<u> </u>
	S <u> </u> T <u> </u> R <u> </u>	<u> </u>
3. Miscellaneous Property in Sec.	S <u> </u> T <u> </u> R <u> </u>	<u> </u>
	S <u> </u> T <u> </u> R <u> </u>	<u> </u>

99-57

STATE OF MICHIGAN
IOSCO COUNTY
FILED

20 DEC 99 10:14 A.M.

BONITA H. COYLE
REGISTER OF DEEDS

Register of Deeds Stamp & File Number

4. Lot No. , Recorded Plat

5. Private Claims

	A	B	C	D	E	F	G	H	I	J	K	L	M
1													
2	6		5		4		3		2		1		
3													
4	7		8		9		10		11		12		
5													
6	18		17		16		15		14		13		
7													
8	19		20		21		22		23		24		
9													
10	30		29		28		27		26		25		
11													
12	31		32		33		34		35		36		
13													

I, JAMES H. GRANGER, in a field survey on November, 1999 do hereby state that under requirements of P.A. 74, Michigan P.A. of 1970, the corner points mentioned in lines 1 and 2 above were in conformance with regulations and rules therefore as required in the current manual of survey instructions of the United States Department of the Interior, Bureau of Land Management or by a decree of a Court of Law and for that the corner points mentioned in lines 3, 4 and 5 above were in conformance with the rules of the Michigan Board of Land Surveyors or by a Decree of a Court of Law, established, re-established, monumented, recovered, found as expressed below:

NOTE: Not more than 2 corners, all in the same town and range, may be recorded on this certificate.

A. Description of original monument and accessories and/or subsequent restoration:

1837 GLO	Set Wood Post	
Lewis Clawson	10" Maple	N39 E 26lks
	20" Hemlock	S47 W 16lks

B. Description of corner evidence found and/or method applied in restoring or reestablishing corner:


Found 1 1/2" iron buried 12" ± inside mon. box. Pipe is similar to other markers along section lines to E. & W. set by Consumers Power for power line easement. Measurements to section corners to S., N. & W. agree well with GLO. Accepted position as established. Set 5/8" rebar inside pipe.

C. Description of monument for corner and accessories established to perpetuate locating the position of the corner:

5/8" x 30" rebar w/ Remon Cap inside 1 1/2" pipe in mon. box		
PP	S71 W	32.59' nail & tag 16041
RR track Centerline	South	41'
P.P.	S70 E	49.79' nail & cap 16041
4" Cedar Post	N72 E	34.74' nail & cap 16041
MDOT cor. #35201	N37 E	42.31' nail & cap 16041

ACCEPTED BY THE IOSCO COUNTY
SURVEY PEER GROUP AS THE
OFFICIAL CORNER UNDER P.A.
345 OF 1990 AT A MEETING
HELD ON 10-13-99

James H. Granger

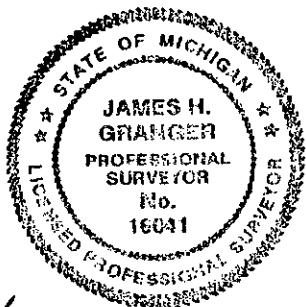

Signed by James H. Granger
Surveyor's Michigan License No. 16041

Date December 15, 1999

APR 27 2000

SECTION