

**IOSCO COUNTY REMONUMENTATION
LAND CORNER RECORDATION CERTIFICATE
Filing Requirement of Act 74, Mich. P.A. 1970**

046 2000

For corners in

Iosco Co.
(County)

Located In:

Corner Code #

1. Public Land Survey

T 21NR 6E

1-4 **SURVEY &
REMONUMENTATION**

2. Property Controlling
in Section


S T R

FEB 15 2001

3. Miscellaneous
Property in Sec.

S T R

SECTION

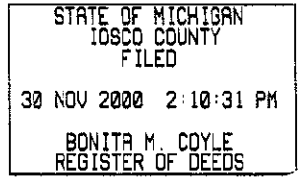

Register of Deeds Stamp & File Number

4. Lot No. _____, Recorded Plat _____

5. Private Claims _____

	A	B	C	D	E	F	G	H	I	J	K	L
1												
2	6			5		4		3		2		1
3												
4	7			8		9		10		11		1
5												
6	18			17		16		15		14		1
7												
8	19			20		21		22		23		2
9												
10	30			29		28		27		26		2
11												
12	31			32		33		34		35		
13												

I, JAMES H. GRANGER, in a field survey on July, 2000 do hereby state that under requirements of P.A. 74, Michigan P.A. of 1970, the corner points mentioned in lines 1 and 2 above were in conformance with regulations and rules therefore as required in the current manual of survey instructions of the United States Department of the Interior, Bureau of Land Management or by a decree of a Court of Law and for that the corner points mentioned in lines 3, 4 and 5 above were in conformance with the rules of the Michigan Board of Land Surveyors or by a Decree of a Court of Law; established, re-established, monumented, recovered, found as expressed below:

NOTE: Not more than 4 corners, all in the same town and range, may be recorded on this certificate.

A. Description of original monument and accessories and/or subsequent restoration:

1843 GLO Set quarter post
John Mullett 18" Maple S47°W 10 lks
J.H. Munro 14" W. Pine N46°E 12 lks

ACCEPTED BY THE IOSCO COUNTY
SURVEY PEER GROUP AS THE
OFFICIAL CORNER UNDER P.A.
345 OF 1990 AT A MEETING
HELD ON OCT. 11, 2000

James H. Granger

B. Description of corner evidence found and/or method applied in restoring or reestablishing corner:

No evidence of corner marker nor witnesses was found.
Established location of corner by single proportionate measurement.

C. Description of monument for corner and accessories established to perpetuate locating the position of the corner:

5/8" x 36" rebar w/Remon Cap in mon. box		nail & tag 16041
5" W. Pine	S40°E 37.96'	nail & tag 16041
PP	S38°W 118.60'	nail & tag 16041
16" W. Pine	N55°E 53.72'	nail & tag 16041
10" W. Pine	N70°W 35.18'	nail & tag 16041



Signed by James H. Granger
Surveyor's Michigan License No. 16041

Date NOV. 29, 2000