

**IOSCO COUNTY REMONUMENTATION
LAND CORNER RECORDATION CERTIFICATE
Filing Requirement of Act 74, Mich. P.A. 1970**

For corners in


048 2000

Iosco Co. Located In: Corner Code #
(County)

1. Public Land Survey T 21NR 06E I-6
T ___ R ___
T ___ R ___
T ___ R ___
T ___ R ___
2. Property Controlling S ___ T ___ R ___
in Section S ___ T ___ R ___
3. Miscellaneous S ___ T ___ R ___
Property in Sec. S ___ T ___ R ___

**SURVEY &
REMONUMENTATION**

FEB 15 2001

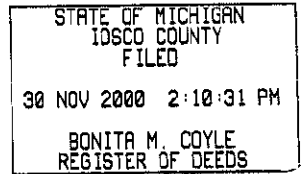

Register of Deeds Stamp & File Number

4. Lot No. _____, Recorded Plat _____ SECTION _____

5. Private Claims _____

	A	B	C	D	E	F	G	H	I	J	K	L
1												
2	6			5		4		3		2		1
3												
4	7			8		9		10		11		1
5												
6	18			17		16		15		14		1
7												
8	19			20		21		22		23		2
9												
10	30			29		28		27		26		2
11												
12	31			32		33		34		35		3
13												

I, JAMES H. GRANGER, in a field survey on July, 2000 do hereby state that under requirements of P.A. 74, Michigan P.A. of 1970, the corner points mentioned in lines 1 and 2 above were in conformance with regulations and rules therefore as required in the current manual of survey instructions of the United States Department of the Interior, Bureau of Land Management or by a decree of a Court of Law and /or that the corner points mentioned in lines 3, 4 and 5 above were in conformance with the rules of the Michigan Board of Land Surveyors or by a Decree of a Court of Law; established, re-established, monumented, recovered, found as expressed below:

NOTE: Not more than 4 corners, all in the same town and range, may be recorded on this certificate.

A. Description of original monument and accessories and/or subsequent restoration:

1843 GLO Set quarter section post
John Mullett 16" Maple S86°W 27 lks
J.H. Munro 12" B. Ash N60°E 69 lks

ACCEPTED BY THE IOSCO COUNTY
SURVEY PEER GROUP AS THE
OFFICIAL CORNER UNDER P.A.
345 OF 1990 AT A MEETING
HELD ON OCT 11, 2000


James H. Granger

B. Description of corner evidence found and/or method applied in restoring or reestablishing corner:

No evidence of marker nor witnesses was found.
Established location of corner by single proportionate measurement

C. Description of monument for corner and accessories established to perpetuate locating the position of the corner:

5/8" x 30" rebar w/Remon Cap in mon. box
PP S17°E 163.71' nail & tag 16041
13" dbl Maple S77°E 31.72' nail & tag 16041
PP N68°E 62.33' nail & tag 16041
Corner fence post N85°W 33.77' nail & tag 16041

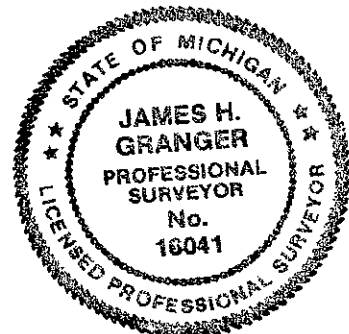

Signed by James H. Granger
Surveyor's Michigan License No. 16041

Date NOV. 29, 2000