

**IOSCO COUNTY REMONUMENTATION
LAND CORNER RECORDATION CERTIFICATE
Filing Requirement of Act 74, Mich. P.A. 1970**


For corners in

Iosco Co. Located In: _____ Corner Code # _____
(County)

049 2000

1. Public Land Survey T 21NR 6E _____ I-7 _____
T _____ R _____
T _____ R _____
T _____ R _____
2. Property Controlling S _____ T _____ R _____
in Section S _____ T _____ R _____
3. Miscellaneous S _____ T _____ R _____
Property in Sec. S _____ T _____ R _____

**SURVEY &
REMONUMENTATION
FEB 15 2001**

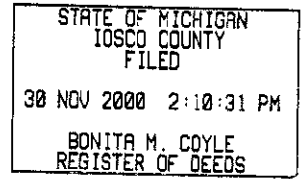

Register of Deeds Stamp & File Number

4. Lot No. _____, Recorded Plat _____ SECTION _____

5. Private Claims _____

	A	B	C	D	E	F	G	H	I	J	K	L	M
1													
2	6			5		4		3		2		1	
3													
4	7			8		9		10		11		12	
5													
6	18			17		16		15		14		13	
7													
8	19			20		21		22		23		24	
9													
10	30			29		28		27		26		25	
11													
12	31			32		33		34		35		36	
13													

I, JAMES H. GRANGER, in a field survey on July, 2000 do hereby state that under requirements of P.A. 74, Michigan P.A. of 1970, the corner points mentioned in lines 1 and 2 above were in conformance with regulations and rules therefore as required in the current manual of survey instructions of the United States Department of the Interior, Bureau of Land Management or by a decree of a Court of Law and for that the corner points mentioned in lines 3, 4 and 5 above were in conformance with the rules of the Michigan Board of Land Surveyors or by a Decree of a Court of Law; established, re-established, monumented, recovered, found as expressed below:

NOTE: Not more than 4 corners, all in the same town and range, may be recorded on this certificate.

A. Description of original monument and accessories and/or subsequent restoration:

1843 GLO Set Corner Post
John Mullett 14" W. Ash S78°E 15 lks
J.H. Munro 12" Elm N59°W 39 lks
1998 Keyno J. Schellenbarger 30101
1999 Keyno J. Schellenbarger 30101

ACCEPTED BY THE IOSCO COUNTY
SURVEY PEER GROUP AS THE
OFFICIAL CORNER UNDER P.A.
345 OF 1990 AT A MEETING
HELD ON OCT. 11, 2000


James H. Granger

B. Description of corner evidence found and/or method applied in restoring or reestablishing corner:

Found existing Corner of record; 1/2" iron w/cap 30101.

C. Description of monument for corner and accessories established to perpetuate locating the position of the corner:

5/8" x 36" rebar w/Remon Cap in mon. box
PP with tag in NE face N50°W 44.14'
PP with tag in NW face N65°E 60.73'
fence post with tag in NE face S45°E 54.36'
fence post with tag in NW face S45°W 49.14'

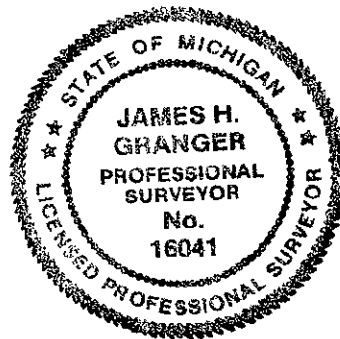

Signed by James H. Granger
Surveyor's Michigan License No. 16041

Date NOV. 29, 2000