

**IOSCO COUNTY REMONUMENTATION
LAND CORNER RECORDATION CERTIFICATE
Filing Requirement of Act 74, Mich. P.A. 1970**

For corners in

050 2000


iosco Co. _____ Located In: _____ Corner Code # _____
(County)

1. Public Land Survey T 21NR 6E _____ I-9 _____
T _____ R _____
T _____ R _____
T _____ R _____
2. Property Controlling S _____ T _____ R _____
in Section S _____ T _____ R _____
3. Miscellaneous S _____ T _____ R _____
Property in Sec. S _____ T _____ R _____

**SURVEY &
REMONUMENTATION**

FEB 15 2001

SECTION

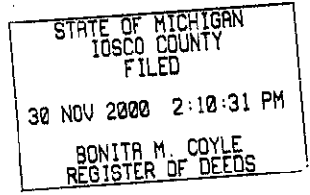

Register of Deeds Stamp & File Number

4. Lot No. _____, Recorded Plat _____
5. Private Claims _____

	A	B	C	D	E	F	G	H	I	J	K	L
1												
2	6			5		4		3		2		1
3												
4	7			8		9		10		11		12
5												
6	18			17		16		15		14		13
7												
8	19			20		21		22		23		24
9												
10	30			29		28		27		26		25
11												
12	31			32		33		34		35		36
13												

I, JAMES H. GRANGER, in a field survey on July, 2000 do hereby state that under requirements of P.A. 74, Michigan P.A. of 1970, the corner points mentioned in lines 1 and 2 above were in conformance with regulations and rules therefore as required in the current manual of survey instructions of the United States Department of the Interior, Bureau of Land Management or by a decree of a Court of Law and for that the corner points mentioned in lines 3, 4 and 5 above were in conformance with the rules of the Michigan Board of Land Surveyors or by a Decree of a Court of Law; established, re-established, monumented, recovered, found as expressed below:

NOTE: Not more than 4 corners, all in the same town and range, may be recorded on this certificate.

A. Description of original monument and accessories and/or subsequent restoration:

1843 GLO Set Post
John Mullett 12" W. Birch N07°E 33 lks
J.H. Munro 8" Y. Birch S65°W 28 lks
1994 James H. Granger 16041

ACCEPTED BY THE IOSCO COUNTY SURVEY PEER GROUP AS THE OFFICIAL CORNER UNDER P.A. 345 OF 1990 AT A MEETING HELD ON OCT. 11, 2000

James H. Granger

B. Description of corner evidence found and/or method applied in restoring or reestablishing corner:

Found existing 1/2" bar per corner record.

C. Description of monument for corner and accessories established to perpetuate locating the position of the corner:

5/8" x 36" rebar w/Remon Cap
Fence Post N34°E 43.66' nail & tag 16041
PP S28°E 81.22' nail & tag 16041
"Dead End" S32°E 42.19'
"Stop" Sign S25°E 28.71'



Signed by James H. Granger
Surveyor's Michigan License No. 16041

Date NOV. 29, 2000