


**IOSCO COUNTY REMONUMENTATION  
LAND CORNER RECORDATION CERTIFICATE  
Filing Requirement of Act 74, Mich. P.A. 1970**

For corners in

Iosco Co. Located In: \_\_\_\_\_ Corner Code # \_\_\_\_\_  
(County)

052 2000

- |                                    |                         |       |
|------------------------------------|-------------------------|-------|
| 1. Public Land Survey              | T 21NR 6E               | J-9   |
|                                    | T _____ R _____         | _____ |
|                                    | T _____ R _____         | _____ |
|                                    | T _____ R _____         | _____ |
| 2. Property Controlling in Section | S _____ T _____ R _____ | _____ |
|                                    | S _____ T _____ R _____ | _____ |
| 3. Miscellaneous Property in Sec.  | S _____ T _____ R _____ | _____ |
|                                    | S _____ T _____ R _____ | _____ |

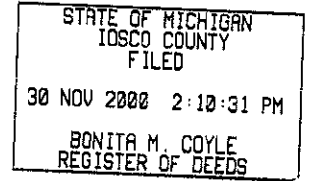

**SURVEY &  
REMONUMENTATION  
FEB 15 2001**

Register of Deeds Stamp & File Number

4. Lot No. \_\_\_\_\_, Recorded Plat \_\_\_\_\_ SECTION \_\_\_\_\_

5. Private Claims \_\_\_\_\_

	A	B	C	D	E	F	G	H	I	J	K	L	I
1													
2		6		5		4		3		2		1	
3													
4		7		8		9		10		11		12	
5													
6		18		17		16		15		14		13	
7													
8		19		20		21		22		23		24	
9													
10		30		29		28		27		26		25	
11													
12		31		32		33		34		35		36	
13													

I, JAMES H. GRANGER, in a field survey on July, 2000 do hereby state that under requirements of P.A. 74, Michigan P.A. of 1970, the corner points mentioned in lines 1 and 2 above were in conformance with regulations and rules therefore as required in the current manual of survey instructions of the United States Department of the Interior, Bureau of Land Management or by a decree of a Court of Law and for that the corner points mentioned in lines 3, 4 and 5 above were in conformance with the rules of the Michigan Board of Land Surveyors or by a Decree of a Court of Law; established, re-established, monumented, recovered, found as expressed below:

**NOTE: Not more than 4 corners, all in the same town and range, may be recorded on this certificate.**

A. Description of original monument and accessories and/or subsequent restoration:

- 1843 GLO Set quarter section post  
John Mullett 16" B. Ash S05°W 12 lks  
J.H. Munro 10" B. Ash N04°W 6 lks

1994 James H. Granger 16041

ACCEPTED BY THE IOSCO COUNTY SURVEY PEER GROUP AS THE OFFICIAL CORNER UNDER P.A. 345 OF 1990 AT A MEETING HELD ON OCT. 11, 2000


*James H. Granger*

B. Description of corner evidence found and/or method applied in restoring or reestablishing corner:

Found existing 1/2" iron per corner record.

C. Description of monument for corner and accessories established to perpetuate locating the position of the corner:

- 5/8" x 36" rebar w/Remon Cap.
- Fence Post S54°W 26.54' nail & tag 16041
- PP N52°E 58.92' nail & tag 16041
- Turtle Rd/Locke Rd Sign S71°E 38.84'
- Fence Post N14°E 62.33' nail & tag 16041

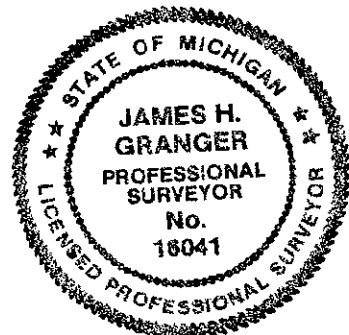

Signed by James H. Granger  
Surveyor's Michigan License No. 16041

Date NOV. 29, 2000