

**IOSCO COUNTY REMONUMENTATION
LAND CORNER RECORDATION CERTIFICATE
Filing Requirement of Act 74, Mich. P.A. 1970**

For corners in


053 2000

Iosco Co. _____ Located In: _____ Corner Code # _____
(County)

1. Public Land Survey T 21NR 6E K-7
T R
T R
T R
2. Property Controlling S T R
in Section S T R
3. Miscellaneous S T R
Property in Sec. S T R

**SURVEY &
REMONUMENTATION**

FEB 15 2001

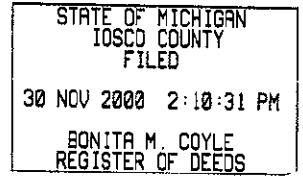

Register of Deeds Stamp & File Number

4. Lot No. _____, Recorded Plat _____ SECTION _____

5. Private Claims _____

	A	B	C	D	E	F	G	H	I	J	K	L
1												
2	6		5		4		3		2		1	
3												
4	7		8		9		10		11		12	
5												
6	18		17		16		15		14		13	
7												
8	19		20		21		22		23		24	
9												
10	30		29		28		27		26		25	
11												
12	31		32		33		34		35		36	
13												

I, JAMES H. GRANGER, in a field survey on July, 2000 do hereby state that under requirements of P.A. 74, Michigan P.A. of 1970, the corner points mentioned in lines 1 and 2 above were in conformance with regulations and rules therefore as required in the current manual of survey instructions of the United States Department of the Interior, Bureau of Land Management or by a decree of a Court of Law and /or that the corner points mentioned in lines 3, 4 and 5 above were in conformance with the rules of the Michigan Board of Land Surveyors or by a Decree of a Court of Law; established, re-established, monumented, recovered, found as expressed below:

NOTE: Not more than 4 corners, all in the same town and range, may be recorded on this certificate.

A. Description of original monument and accessories and/or subsequent restoration:

1843 GLO Set Post
John Mullett 14" B. Ash N31°E 22 lks
J.H. Munro 14" B. Ash S78°W 40 lks

1998 Keyno J. Schellenbarger 30101 Liber 98, page 10

ACCEPTED BY THE IOSCO COUNTY
SURVEY PEER GROUP AS THE
OFFICIAL CORNER UNDER P.A.
345 OF 1990 AT A MEETING
HELD ON OCT. 11, 2000


James H. Granger

B. Description of corner evidence found and/or method applied in restoring or reestablishing corner:

Found 5/8" rerod in mon. box verified location against LCRC witnesses of record.

C. Description of monument for corner and accessories established to perpetuate locating the position of the corner:

5/8" x 30" rebar w/Remon Cap. in mon. box		
tag with face PP	N05° E 27.78'	nail & tag 16041
tag NE face 18" R. Pine	S60° E 77.40'	nail & tag 16041
tag W. face 8" Ash	S25° E 83.53'	nail & tag 16041
top of Ameritech box	S50°W 54.36'	

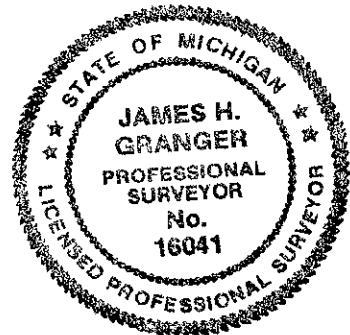

Signed by James H. Granger
Surveyor's Michigan License No. 16041

Date NOV. 29, 2000