

SURVEY & REMONUMENTATION

FEB 16 1999

SECTION

REMONUMENTATION CORNER

LAND CORNER RECORDATION CERTIFICATE
Filing Requirement of Act 74, Mich. P.A. 1970

STATE OF MICHIGAN
IOSCO COUNTY

98-23
8 DEC 98 1:11 P.M.

RONITA M. COYLE
REGISTER OF DEEDS

For corners in

IOSCO (County) Located In: T21N R6E Corner Code # L-1
1. Public Land Survey
2. Property Controlling in Section
3. Miscellaneous Property in Sec.

4. Lot No. Recorded Plat
5. Private Claims

Register of Deeds Stamp & File Number

Table with columns A-M and rows 1-13 for recording corners.

I, JAMES H. GRANGER, in a field survey on SEPTEMBER 29, 19 98 do hereby state that under requirements of P.A. 74, Michigan P.A. of 1970, the corner points mentioned in lines 1 and 2 above were in conformance with regulations and rules therefore as required in the current manual of survey instructions of the United States Department of the Interior, Bureau of Land Management or by a decree of a Court of Law and/or that the corner points mentioned in lines 3, 4 and 5 above were in conformance with the rules of the Michigan Board of Land Surveyors or by a Decree of a Court of Law, established, re-established, monumented, recovered, found as expressed below:

NOTE: Not more than 2 corners, all in the same town and range, may be recorded on this certificate.

A. Description of original monument and accessories and/or subsequent restoration:

No original GLO notes

B. Description of corner evidence found and/or method applied in restoring or reestablishing corner:

Measured distance from NE cor. Sec. 1 to NW cor. Sec. 2 established position of NW cor. Sec. 1 by single proportionate measurement with evaluation of measurements on N. Side of Township line and closing corners with offsets. Then established corner location halfway and on line between NE and NW Sec. Cor. Found old fence 11.4' west of calc. position. Established corner as calculated 2,595.96 ft. West of NE Cor. Sec. 1


C. Description of monument for corner and accessories established to perpetuate locating the position of the corner:

Set 5/8" x 24" iron rod w/ remon cap

- Maple 16" dia. S83°E 47.20' nail and tag
Maple 12" dia. S25°E 49.54' nail and tag
Ut. Pole S10°W 15.65' nail and tag
6"x6" treated gate post N42°W 7.72' nail and tag

ACCEPTED BY THE IOSCO COUNTY SURVEY PEER GROUP AS THE OFFICIAL CORNER UNDER P.A. 345 OF 1990 AT A MEETING HELD ON 9-22-98

James H. Granger

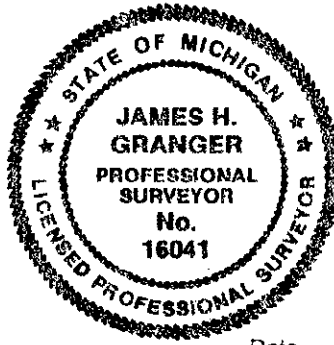

Signed by James H. Granger

Date November 2, 1998

Surveyor's Michigan License No. 16041