

**SURVEY & REMONUMENTATION**

**MAR 18 1998**

**SECTION**

**REMONUMENTATION CORNER  
LAND CORNER RECORDATION CERTIFICATE  
Filing Requirement of Act 74, Mich. P.A. 1970**

STATE OF MICHIGAN  
IOSCO COUNTY  
FILED

3 DEC 97 11:47 A.M.

BONITA M. COYLE  
REGISTER OF DEEDS

**97-41**

Register of Deeds Stamp & File Number

For corners in

<u>Iosco</u> (County)	Located In:	Corner Code #
1. Public Land Survey	T22N R7E	A-13
	T22N R6E	M-13
	T21N R6E	M-1
	T21N R7E	A-1
2. Property Controlling in Section	S ___ T ___ R ___	___
	S ___ T ___ R ___	___
3. Miscellaneous Property in Sec.	S ___ T ___ R ___	___
	S ___ T ___ R ___	___

4. Lot No. \_\_\_\_\_, Recorded Plat \_\_\_\_\_  
5. Private Claims \_\_\_\_\_

I, James H. Granger, in a field survey on August 4, 1997 do hereby state that under requirements of P.A. 74, Michigan P.A. of 1970, the corner points mentioned in lines 1 and 2 above were in conformance with regulations and rules therefore as required in the current manual of survey instructions of the United States Department of the Interior, Bureau of Land Management or by a decree of a Court of Law and/or that the corner points mentioned in lines 3, 4 and 5 above were in conformance with the rules of the Michigan Board of Land Surveyors or by a Decree of a Court of Law; established, re-established, monumented, recovered, found as expressed below:

NOTE: Not more than 2 corners, all in the same town and range, may be recorded on this certificate.

A	B	C	D	E	F	G	H	I	J	K	L	M
1												
2	6		5		4		3		2		1	
3												
4	7		8		9		10		11		12	
5												
6	18		17		16		15		14		13	
7												
8	19		20		21		22		23		24	
9												
10	30		29		28		27		26		25	
11												
12	31		32		33		34		35		36	
13												

A. Description of original monument and accessories and/or subsequent restoration:  
1838 GLO Louis Clason Set Wood Post  
12" Hemlock S34°W 22 LKS  
12" Hemlock N44°E 28 LKS


B. Description of corner evidence found and/or method applied in restoring or reestablishing corner:  
FD 5/8" Round Head Iron Pin. Single proportionate measurement to SE Cor. of Sec 31 fits acceptably.  
Accept position as previously established.

ACCEPTED BY THE IOSCO COUNTY SURVEY PEER GROUP AS THE OFFICIAL CORNER UNDER P.A. 345 OF 1990 AT A MEETING HELD ON 9-16-97

*James H. Granger*

C. Description of monument for corner and accessories established to perpetuate locating the position of the section:  
Set 5/8" rebar with Remon Cap in Mon Box.

Utility Pole	N45°E	52.02'	nail & tag 16041
Utility Pole	S51°E	48.74'	nail & tag 16041
12" Aspen	S 4°E	38.00'	nail & tag 16041
22" Aspen	S70°W	86.92'	nail & tag 16041

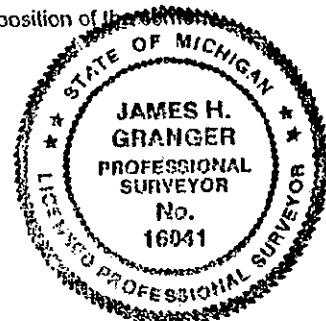

Signed by James H. Granger  
Surveyor's Michigan License No. 16041

Date November 10, 1997