

**IOSCO COUNTY REMONUMENTATION
LAND CORNER RECORDATION CERTIFICATE
Filing Requirement of Act 74, Mich. P.A. 1970**

For corners in

<u> Iosco </u> <small>(County)</small>	Located In:	Corner Code #
1. Public Land Survey	T <u>22</u> NR <u>6E</u> T <u>21</u> NR <u>7E</u> T <u> </u> R <u> </u> T <u> </u> R <u> </u>	<u>M-2</u> <i>Sherman</i> <u>A-2</u>
2. Property Controlling in Section	S <u> </u> T <u> </u> R <u> </u> S <u> </u> T <u> </u> R <u> </u>	
3. Miscellaneous Property in Sec.	S <u> </u> T <u> </u> R <u> </u> S <u> </u> T <u> </u> R <u> </u>	
4. Lot No. <u> </u> , Recorded Plat <u> </u>		
5. Private Claims <u> </u>		

99-45

STATE OF MICHIGAN
IOSCO COUNTY
FILED

Register of Deeds Stamp & File Number

RONITA M. COYLE
REGISTER OF DEEDS

	A	B	C	D	E	L	M
1							
2	6			5	4	3	2 1
3							
4	7			8	9	10	11 12
5							
6	18			17	16	15	14 13
7							
8	19			20	21	22	23 24
9							
10	30			29	28	27	26 25
11							
12	31			32	33	34	35 36
13							

I, JAMES H. GRANGER, in a field survey on November, 1999 do hereby state that under requirements of P.A. 74, Michigan P.A. of 1970, the corner points mentioned in lines 1 and 2 above were in conformance with regulations and rules therefore as required in the current manual of survey instructions of the United States Department of the Interior, Bureau of Land Management or by a decree of a Court of Law and for that the corner points mentioned in lines 3, 4 and 5 above were in conformance with the rules of the Michigan Board of Land Surveyors or by a Decree of a Court of Law, established, re-established, monumented, recovered, found as expressed below:

NOTE: Not more than 2 corners, all in the same town and range, may be recorded on this certificate.

A. Description of original monument and accessories and/or subsequent restoration:

1837 GLO	Set Wood Post	
Lewis Clawson	6" W. Ash	N22°W 33lks
	20" Tamarack	S41°W 40lks

B. Description of corner evidence found and/or method applied in restoring or reestablishing corner:


Extended straight line from SE to NE Sec. Corners and measured halfway to position. No evidence found. Located N-S fence approx. 27' west with iron set by PS 41108 at intersection with fence E. Iron within one ft of halfway between SE & NE sec. corners. Accepted position as established. Replaced 1/2" rebar with 5/8" x 30" rebar

C. Description of monument for corner and accessories established to perpetuate locating the position of the corner:

5/8" rebar w/ Remon Cap		
4" W. Ash	N30°W	23.10' nail & cap 16041
4" W. Ash	S55°E	20.64' nail & cap 16041
4" W. Ash	S12°E	18.24' nail & cap 16041
4" W. Ash	N10°W	17.85' nail & cap 16041

ACCEPTED BY THE IOSCO COUNTY
SURVEY PEER GROUP AS THE
OFFICIAL CORNER UNDER P.A.
345 OF 1990 AT A MEETING
HELD ON 10-13-99

James H. Granger

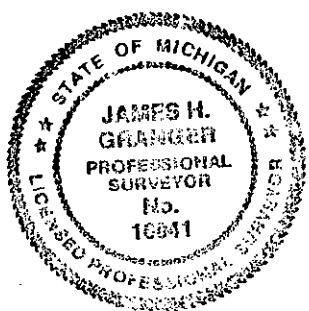

Signed by James H. Granger Date December 14, 1999
Surveyor's Michigan License No. 16041

RECORDED
APR 27 2000
SECTION