

**IOSCO COUNTY REMONUMENTATION
LAND CORNER RECORDATION CERTIFICATE
Filing Requirement of Act 74, Mich. P.A. 1970**

99-46

For corners in

<u>iosco</u> (County)	Located In:	Corner Code #
1. Public Land Survey	T 21NR 06E T 21NR 7E	<u>M-3</u> <u>A-3</u>
2. Property Controlling in Section	S ___ T ___ R ___ S ___ T ___ R ___	___ ___
3. Miscellaneous Property in Sec.	S ___ T ___ R ___ S ___ T ___ R ___	___ ___

STATE OF MICHIGAN
IOSCO COUNTY
FILED

20 DEC 99 10:12 A.M.

DONITA M. COYLE
REGISTER OF DEEDS

Register of Deeds Stamp & File Number

4. Lot No. _____, Recorded Plat _____

5. Private Claims _____

1	A	B	C	D	E	F	G	H	I	J	K	L	M
2	6		5		4		3		2		1		
3													
4	7		8		9		10		11		12		
5													
6	18		17		16		15		14		13		
7													
8	19		20		21		22		23		24		
9													
10	30		29		28		27		26		25		
11													
12	31		32		33		34		35		36		
13													

I, JAMES H. GRANGER, in a field survey on November, 1999 do hereby state that under requirements of P.A. 74, Michigan P.A. of 1970, the corner points mentioned in lines 1 and 2 above were in conformance with regulations and rules therefore as required in the current manual of survey instructions of the United States Department of the Interior, Bureau of Land Management or by a decree of a Court of Law and /or that the corner points mentioned in lines 3, 4 and 5 above were in conformance with the rules of the Michigan Board of Land Surveyors or by a Decree of a Court of Law; established, re-established, monumented, recovered, found as expressed below:

NOTE: Not more than 2 corners, all in the same town and range, may be recorded on this certificate.

A. Description of original monument and accessories and/or subsequent restoration:

1837 GLO Set Wood Post
Lewis Clason 10" W. Pine S68°W 22lks
 7" Tamarack N52°W 25lks


B. Description of corner evidence found and/or method applied in restoring or reestablishing corner:

Extended Township line N. from SE cor. Sec. 13. Found 1 1/2" iron pipe at location. Pipe is consistent with markers to E. and W. established by Consumers Power Co. for electric line easement. Accepted marker as established. Placed 5/8" x 30" rebar inside 1 1/2" pipe.

C. Description of monument for corner and accessories established to perpetuate locating the position of the corner:

5/8" x 30" rebar w/ Remon Cap inside 1 1/2" pipe.
15" Red Maple N10° E 123.95' nail & tag 16041
7" Tamarack N10 W 168.09' nail & tag 16041
6" W. Birch S27° W 64.13' nail & tag 16041
S. Leg of Elec Tower N50 E 115.00' nail & tag 16041

ACCEPTED BY THE IOSCO COUNTY
SURVEY PEER GROUP AS THE
OFFICIAL CORNER UNDER P.A.
345 OF 1990 AT A MEETING
HELD ON 10-13-99
James H. Granger

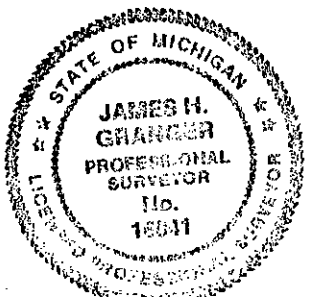

Signed by James H. Granger
Surveyor's Michigan License No. 16041

Date December 14, 1999

SURVEY &
REMONUMENTATION

APR 27 2000

SECTION