


**IOSCO COUNTY REMONUMENTATION  
LAND CORNER RECORDATION CERTIFICATE  
Filing Requirement of Act 74, Mich. P.A. 1970**

For corners in

**055 2000**

iosco Located In: \_\_\_\_\_ Corner Code # \_\_\_\_\_  
(County)

1. Public Land Survey T 21NR 6E M-4 ✓  
T 21NR 7E A-4  
T \_\_\_\_\_ R \_\_\_\_\_  
T \_\_\_\_\_ R \_\_\_\_\_  
2. Property Controlling S \_\_\_\_\_ T \_\_\_\_\_ R \_\_\_\_\_  
in Section S \_\_\_\_\_ T \_\_\_\_\_ R \_\_\_\_\_  
3. Miscellaneous S \_\_\_\_\_ T \_\_\_\_\_ R \_\_\_\_\_  
Property in Sec. S \_\_\_\_\_ T \_\_\_\_\_ R \_\_\_\_\_

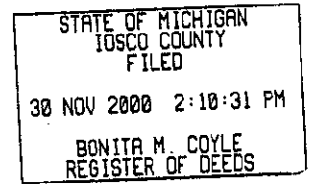

**SURVEY &  
REMONUMENTATION**

**FEB 15 2001**

Register of Deeds Stamp & File Number

4. Lot No. \_\_\_\_\_, Recorded Plat \_\_\_\_\_ SECTION \_\_\_\_\_

5. Private Claims \_\_\_\_\_

	A	B	C	D	E	F	G	H	I	J	K	L	P
1													
2	6		5		4		3		2		1		
3													
4	7		8		9		10		11		12		
5													
6	13		17		16		15		14		13		
7													
8	19		20		21		22		23		24		
9													
10	30		29		28		27		26		25		
11													
12	31		32		33		34		35		36		
13													

I, JAMES H. GRANGER, in a field survey on November, 1999 do hereby state that under requirements of P.A. 74, Michigan P.A. of 1970, the corner points mentioned in lines 1 and 2 above were in conformance with regulations and rules therefore as required in the current manual of survey instructions of the United States Department of the Interior, Bureau of Land Management or by a decree of a Court of Law and for that the corner points mentioned in lines 3, 4 and 5 above were in conformance with the rules of the Michigan Board of Land Surveyors or by a Decree of a Court of Law; established, re-established, monumented, recovered, found as expressed below:

**NOTE: Not more than 2 corners, all in the same town and range, may be recorded on this certificate.**

A. Description of original monument and accessories and/or subsequent restoration:

1837 GLO Set Wood Post  
Lewis Clawson 12" W. Pine S38°W 39lks  
20" Tamarack N44°W 14lks

B. Description of corner evidence found and/or method applied in restoring or reestablishing corner:

Measured distance & established Township line from SE cor. Sec. 13 to NE cor. Sec. 12. Established SE cor. Sec. 12 halfway and on-line. Established E 1/4 Cor. halfway and on-line between NE & SE Sec. corners. No original evidence found. Accepted position as determined by single proportionate measurement from SE cor. Sec. 13 to NE cor. Sec. 12.

C. Description of monument for corner and accessories established to perpetuate locating the position of the corner:

5/8" x 30" rebar w/ Remon Cap  
Red Maple Cluster N52°W 15.75' nail & tag 16041  
14" R. Maple N69°E 56.11' nail & cap 16041  
8" R. Birch S36°E 56.18' nail & cap 16041  
12" Dbl. Maple S26°E 40.0' nail & cap 16041

Replaces LCRC filed as L99, P47.

ACCEPTED BY THE IOSCO COUNTY SURVEY PEER GROUP AS THE OFFICIAL CORNER UNDER P.A. 345 OF 1990 AT A MEETING HELD ON 10-12-99

*James H. Granger*



Signed by James H. Granger  
Surveyor's Michigan License No. 16041

Date NOV. 29, 2000